




T. 27 S., R. 18 E., W.M.

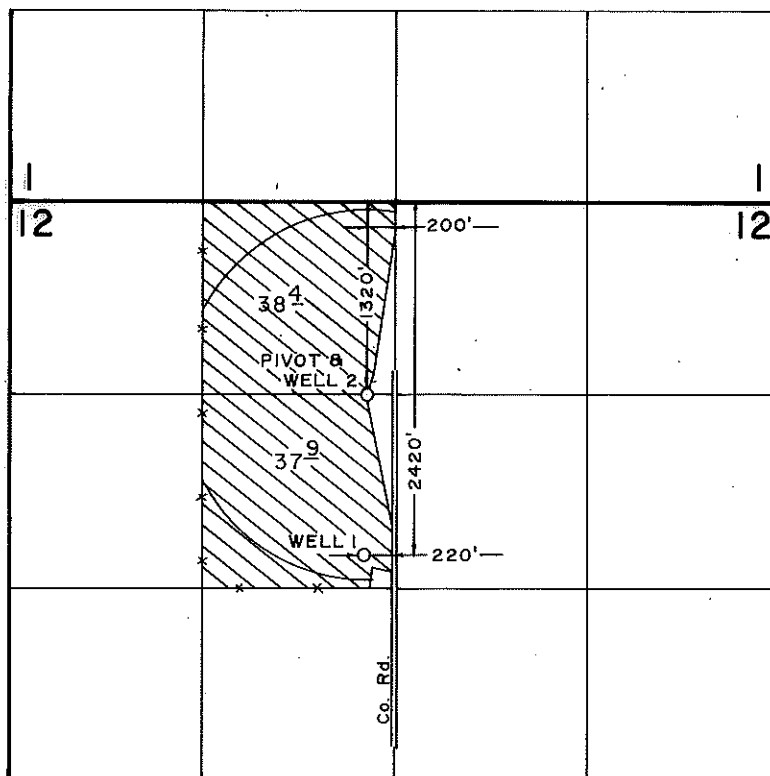

SCALE: 1" = 1320'

FINAL PROOF SURVEY
UNDER

Application No. G-11152, Permit No. G-10268
IN NAME OF

B. JOE WADE

Surveyed JULY 12, 1989, by B. W. BISHOP

JS