


64042

G-10421

T. 6 N. R. 35 E. W.M.



Scale 1" = 1320'

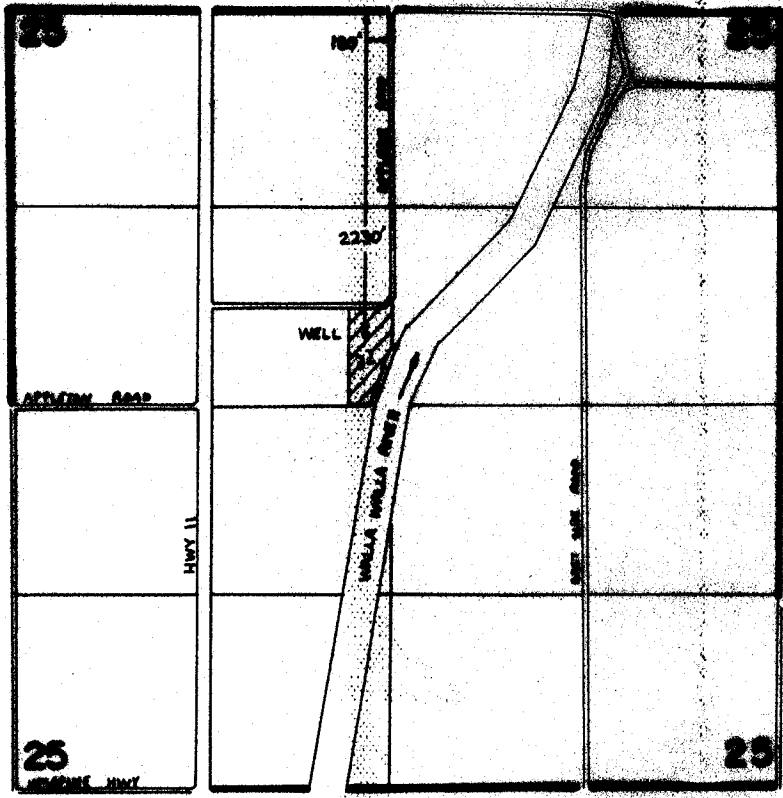

FINAL PROOF SURVEY UNDER

Application No. G11185... Permit No. G10421...
IN NAME OF

...LUKE H. & GLADYS B. BRONN...

Surveyed March.16. 1987., by Y. CHURCH.....