




# T. 26 S., R. 18 E., W.M.

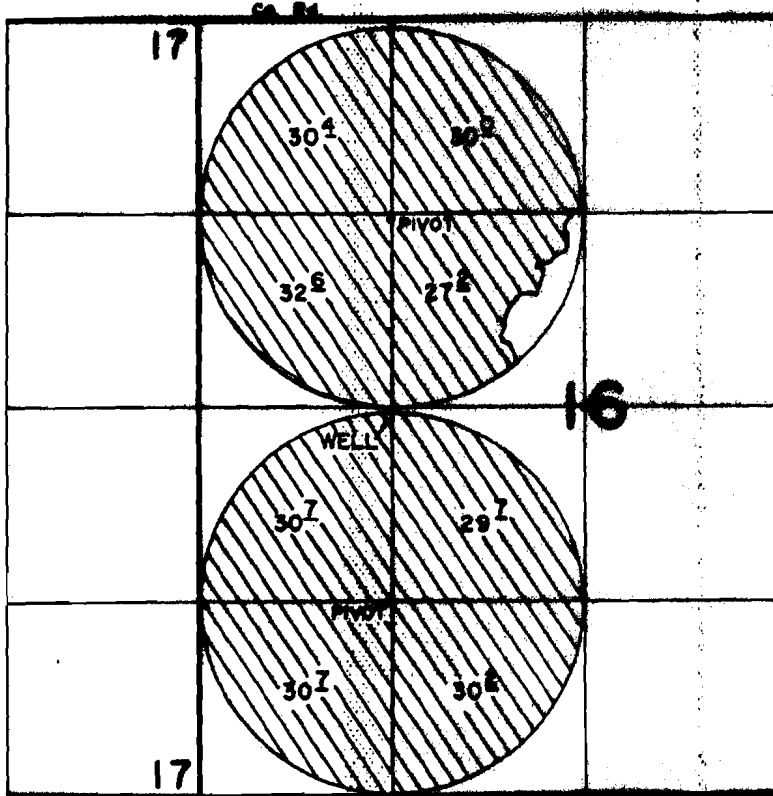

WELL LOC: 2690' S. & 1310' E. FROM N.W. CORNER SECTION 16

SCALE: 1" = 1320'

## FINAL PROOF SURVEY UNDER

Application No. G-11214. Permit No. G-10318  
IN NAME OF

**FREDERICK J. MARTI & WILLIAM H. PITTOCK**

Surveyed JULY 10, 1989, by B. W. BISHOP