


G 10492⁵
64044

RECEIVED


APR 18 1985


WATER RESOURCES DEPT
SALEM, OREGON

T. 15., R. 32E., W.M.

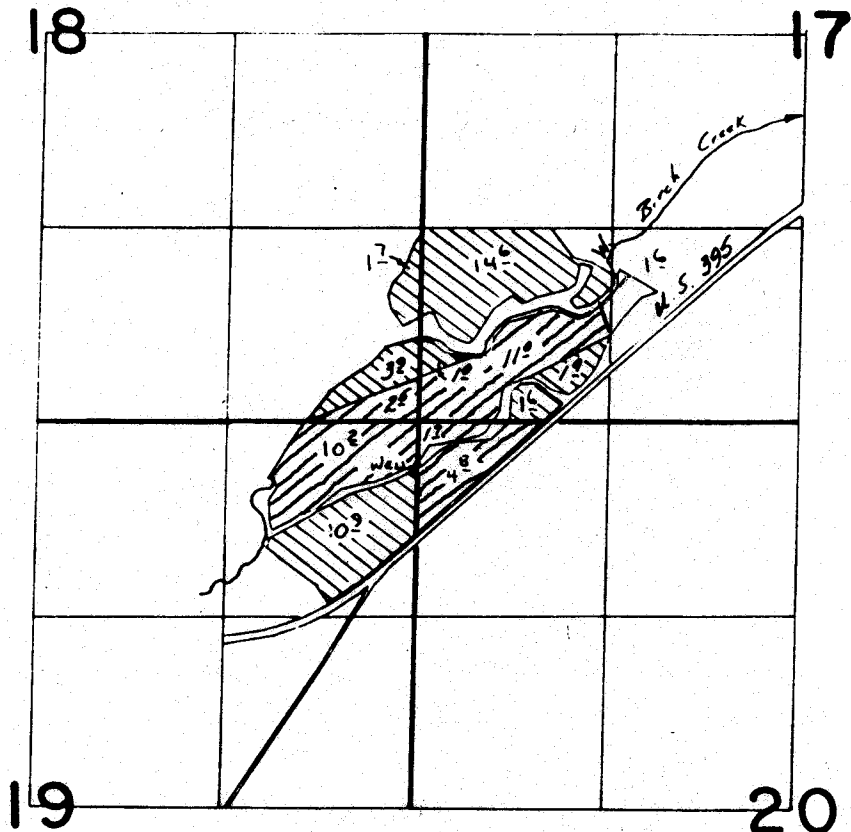

WELL Loc: 330'S & 10'W. From NE Cor. Sec 19

 Lands allowed a water right
as described by certificate 52903

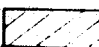 Lands to be covered by permit
approving application G-11325



SCALE: 1" = 1320'

Application No. G-11325
Permit No. G10492