




T. 26 S., R. 19 E., W.M.

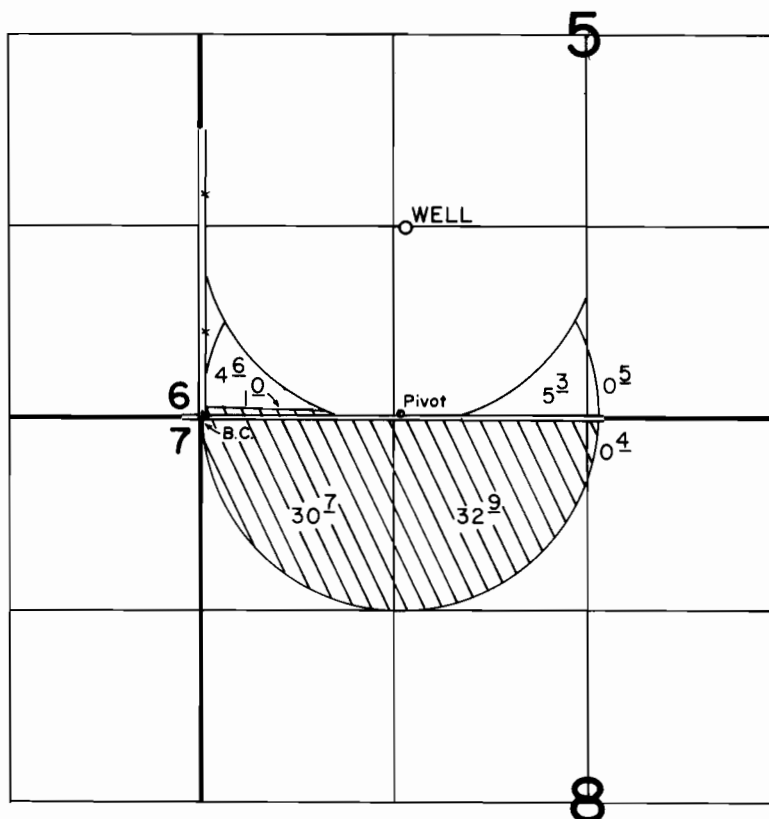

WELL LOC.: 1320' N. & 1390' E. FROM S.W. CORNER SECTION 5.

SCALE: 1" = 1320'

FINAL PROOF SURVEY UNDER

Application No. G-11620 Permit No. G-10791
IN NAME OF

RICHARD MENSCH

Surveyed JULY 11, 1989, by L. L. CAREY