


T.2S., R.4 W., W.M.

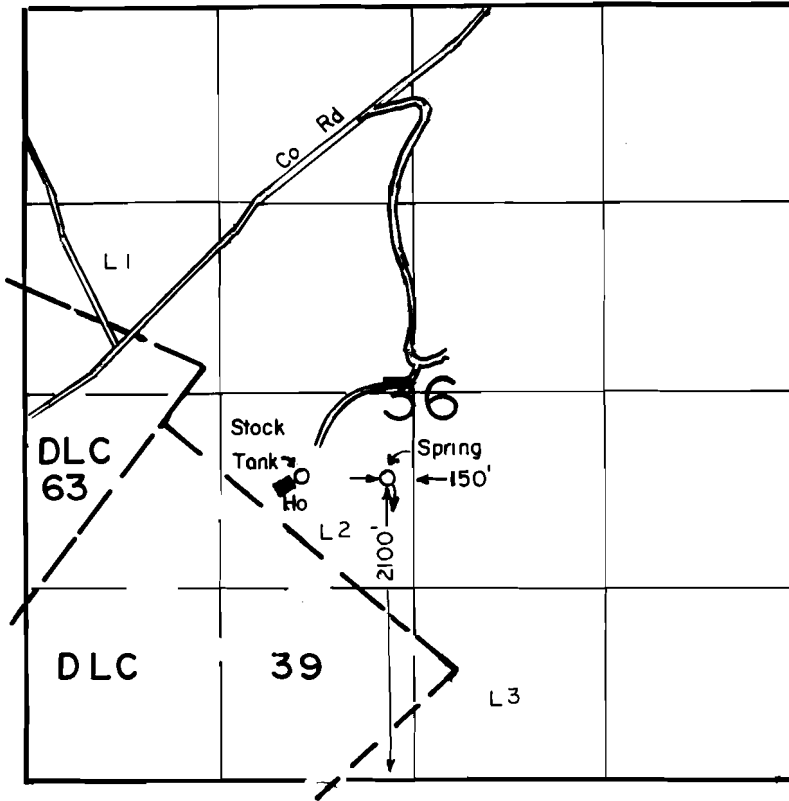

SCALE: 1" = 1320'

FINAL PROOF SURVEY
UNDER

Application No. 47456... Permit No. 35553.....
IN NAME OF

...**ROBERT & DONNA DELIKAT**...

Surveyed .APRIL.17. 1989., by .J.M.WARREN.....