


# T.10S., R.4 W., W.M.

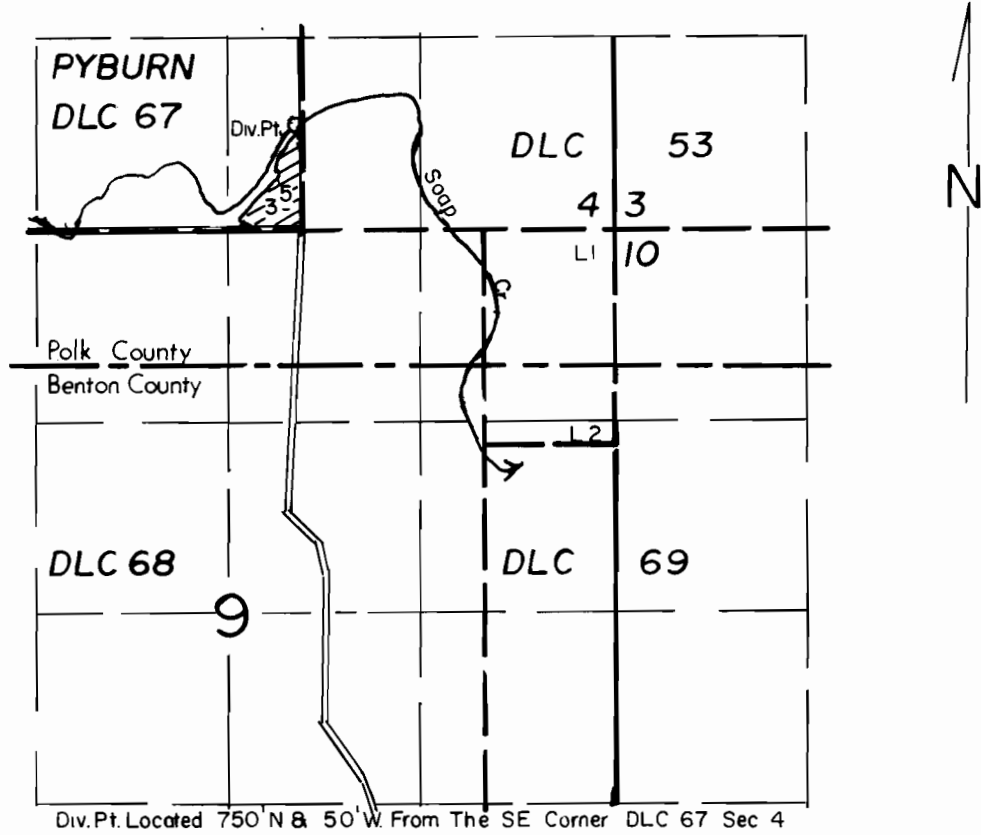

SCALE: 1" = 1320'

## FINAL PROOF SURVEY

UNDER

Application No. 49779... Permit No. 37265.....  
IN NAME OF

.....LAVERN.....LEPPIN.....

Surveyed MAY...12... 1989., by I.M. WARREN.....