


T. 2 N. R. 30 E. W. M.

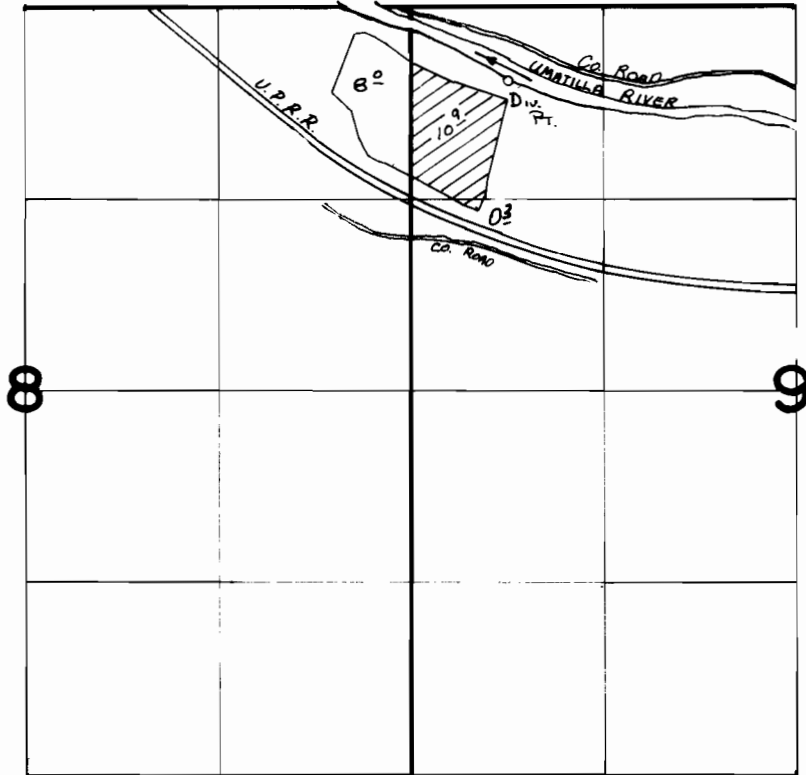

SCALE: 1" = 1320'



Div. Pt. LOCATED 510' S. AND 670' E. FROM N.W. COR. SEC. 9

FINAL PROOF SURVEY UNDER

Application No. 53877. Permit No. 40201.....
IN NAME OF

.....YGNACIO PEDRO ARISTEQUI.....

Surveyed ...4-23... 1984, by V.L.CHURCH.....