


T.4&5S., R.6W., W.M.

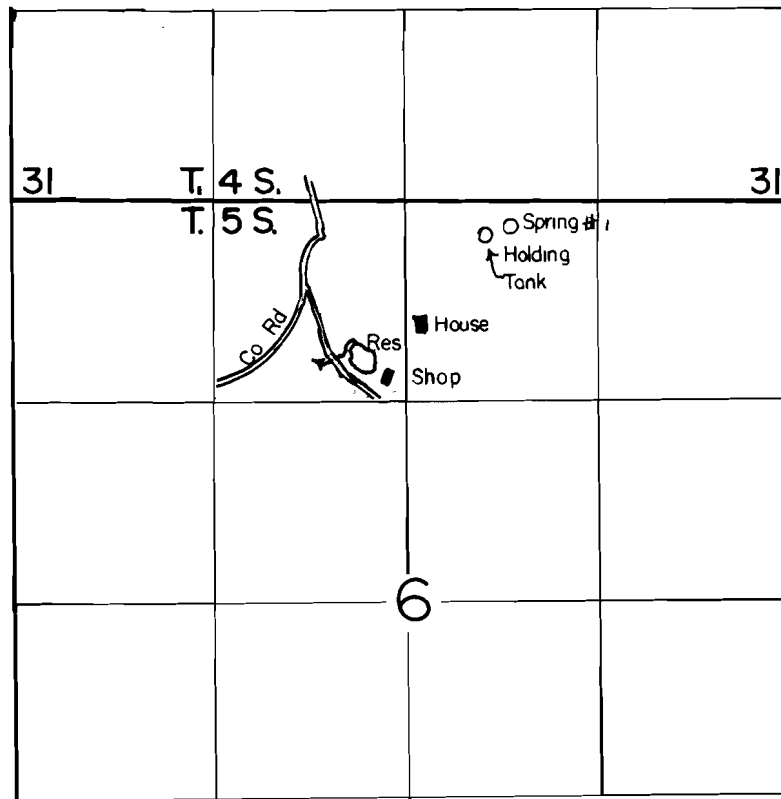

Spring 1 Located 150' S. & 700' E., Spring 2 (Res) Located 950' S. & 350' W.
Both From The N1/4 Corner Of Section 6

SCALE: 1" = 1320'

FINAL PROOF SURVEY UNDER

R - 58894

R - 8111

Application No. 58895..... Permit No. 44798.....

IN NAME OF

NILS LOU

Surveyed MAY...2.... 1989., by J.M. WARREN.....