


T.3&4S., R.3W., W.M.

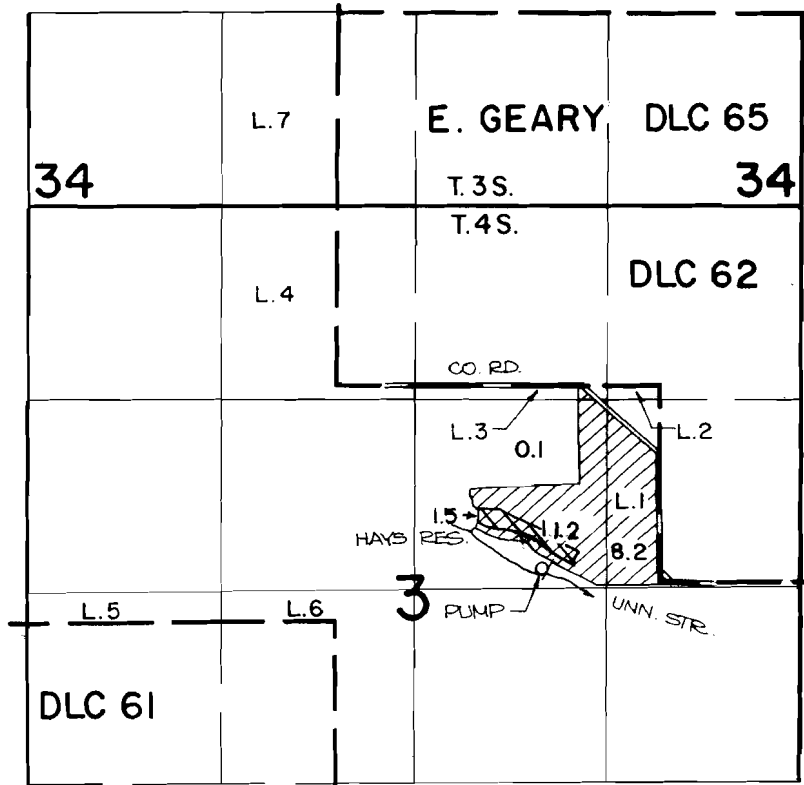

DAM LOCATION: 130 FT. N. AND 800 FT. E. FROM THE CENTER OF SECTION 3.

PRIMARY SUPPLEMENTAL



FINAL PROOF SURVEY
UNDER

SCALE: 4" = 1 MILE

R-59017 R-8148
Application No. 59018... Permit No. 44945...
IN NAME OF

LARRY HAYS

Surveyed JULY 18, 1984, by P. Paster