


T. 1 S., R. 5 W., W. M.

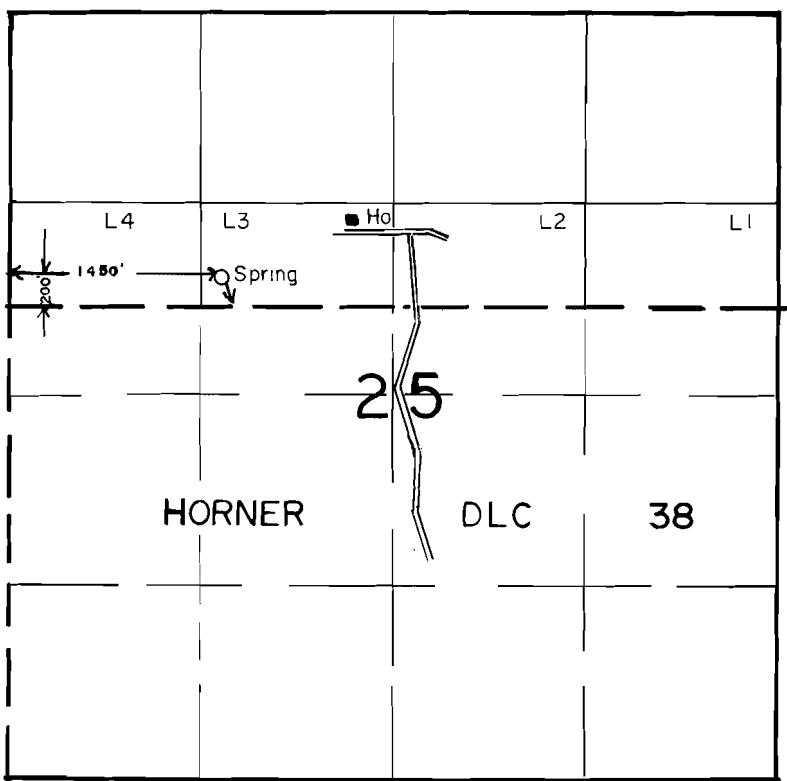

SCALE: 1" = 1320'

FINAL PROOF SURVEY UNDER

Application No. 59849... Permit No. 44957.....
IN NAME OF

.....MONA.....M.....HARRIS.....

Surveyed JUNE 8.... 1989., by T.M. WARREN.....