


T. 1 S., R. 5 W., W. M.

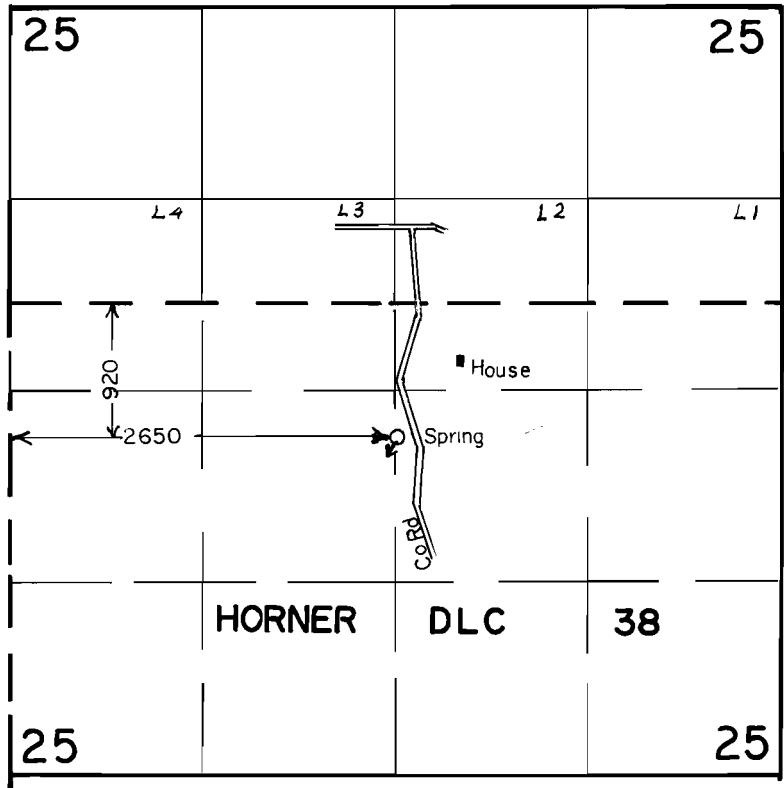

SCALE: 1" = 1320'

FINAL PROOF SURVEY UNDER

Application No. 59867..... Permit No. 44959.....

IN NAME OF
RAYMOND L. MACK
...JANET L. & RONALD E. GLASGOW...

Surveyed JUNE 8, 1989, by T.M. WARREN.....