

W.M. TOWNSHIP 10 S. RANGE 35 E.W.M.

RECEIVED


MAY 17 1982
WATER RESOURCES DEPT.
SALEM, OREGON

POINT of Div #1
600' NE 400' W
of NW COR of
SEC 33

POINT of Div #2
1600' E of SW
COR of SEC 33

N 28

POINT 1 of
DIVERSION
UNY ABT DUMPING
Creek
THROWN OUT
PROPERTIES

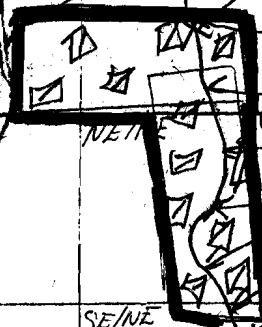

Application No. 66618
Permit No. 46619

MAP TO ACCOMPANY APPLICATION OF:
Name ALVA LEE PRIEST & ROSS O. PRIEST
County CLATSOP
4-27-1981

Indicates
SETTLING POND
200' L X 200' W X 5' DEPTH

POINT 2 of
DIVERSION