


T.2S.,R.5W.,W.M.

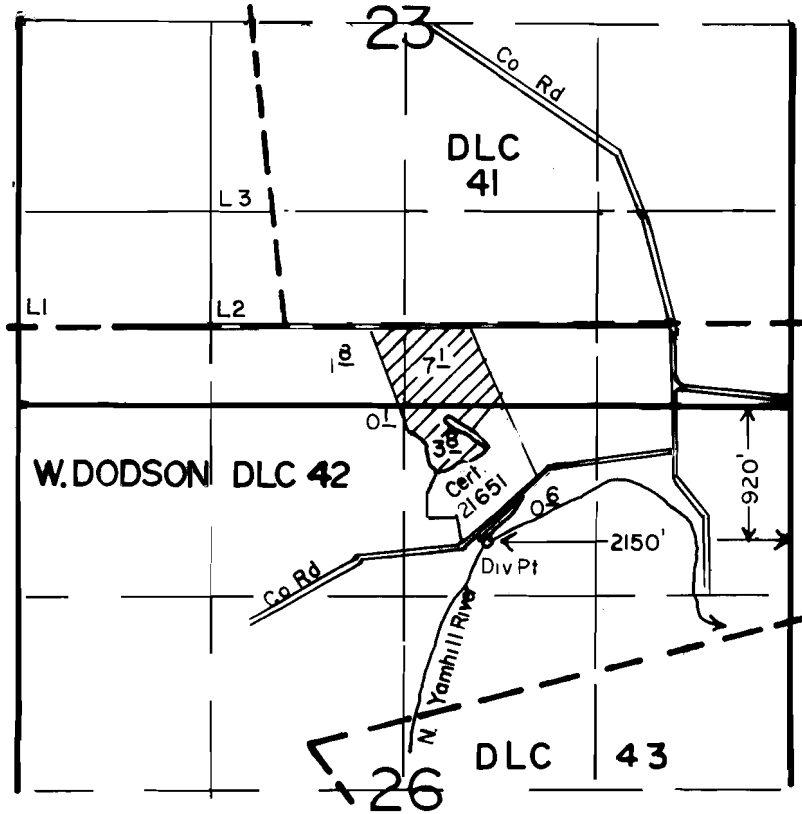

SCALE: 1" = 1320'

FINAL PROOF SURVEY
UNDER

Application No. 61688..... Permit No. 45788.....
IN NAME OF

MARCUS FIDEL

Surveyed APRIL 26, 1989, by I. M. WARREN.....