


T. 38 S., R. 3 W., W. M.

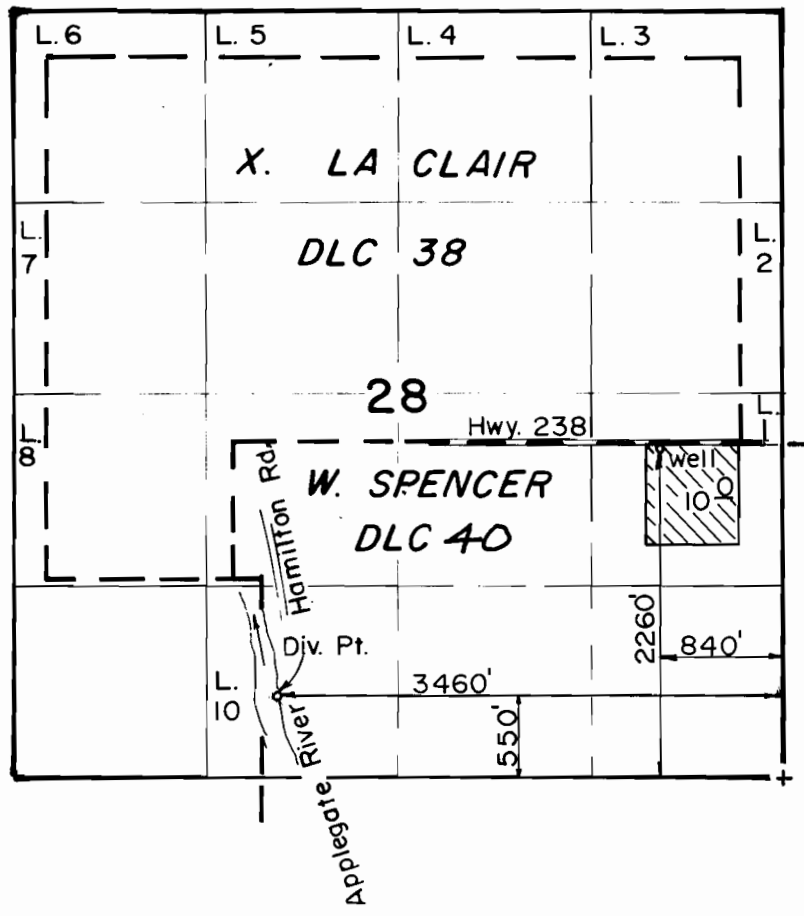

Scale:
1" = 1320'

FINAL PROOF SURVEY
UNDER

G-10267 G-9410

Application No. **62336** Permit No. **46488**...
IN NAME OF

RICHARD L. SHARP

Surveyed JAN. 14, 1988, by B. S. JAMES...