# T. 4 S., R. 5 & 6 W., W.M.

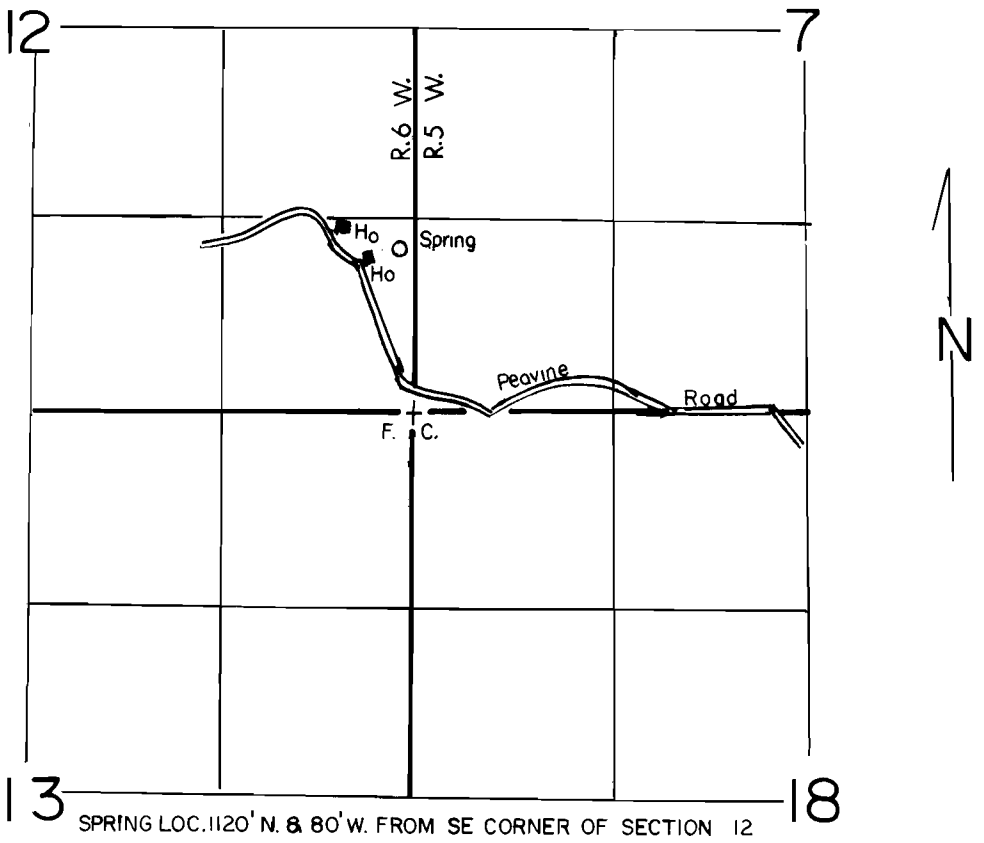


SCALE: 1" = 1320'

## FINAL PROOF SURVEY
### UNDER

**Application No.** 62910 **Permit No.** 47197

**IN NAME OF**

JOYCE C. & WILLIAM K. SAVAGE JR.

**Surveyed** APRIL 27 **1989., by** T. M. WARREN

41071-178-21L 9-28-89 DM