


# T. 26S., R. 13W., W.M.

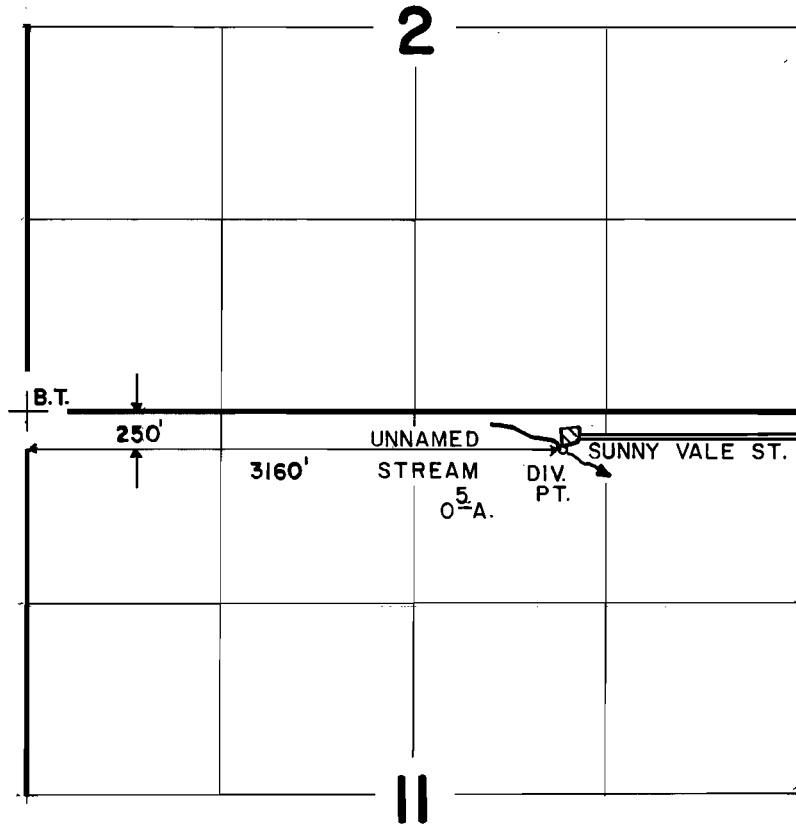

SCALE: 4" = 1 MILE

## FINAL PROOF SURVEY UNDER

Application No. 59952 Permit No. 45446  
IN NAME OF

ROBERT R. & ROSE L. LOVIE

Surveyed JULY 3 1986, by J. M. SCHMORDE