



T17S, R3W, WM

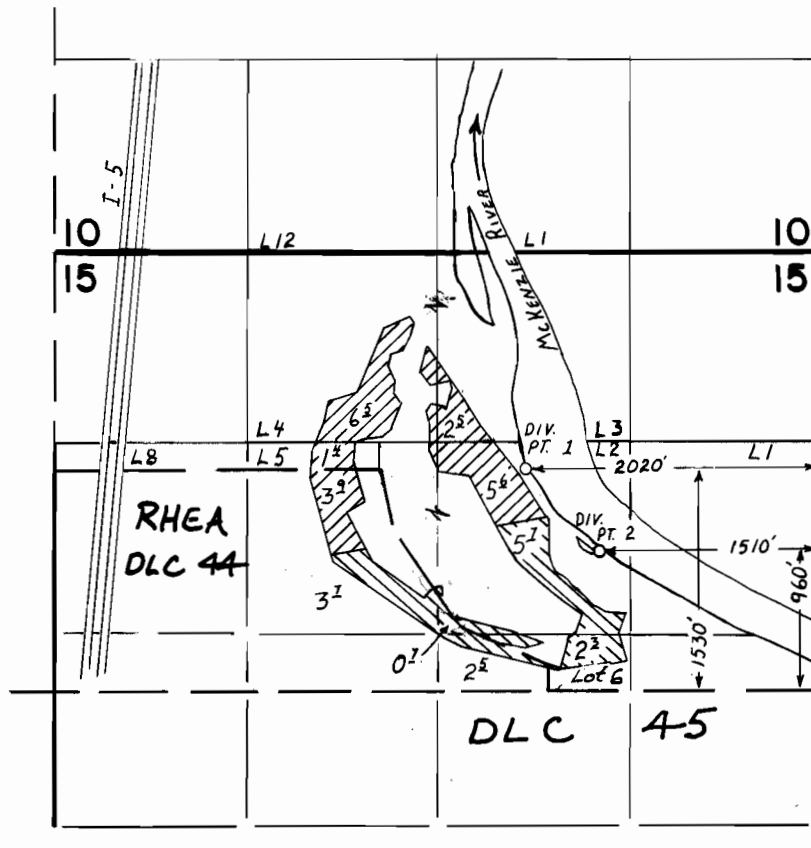

SCALE
1" = 1320'

FINAL PROOF SURVEY UNDER

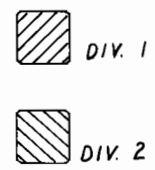

Application No. 63955. Permit No. 47223....
IN NAME OF

.....ERIC DOUGLAS WICKLUND.....

Surveyed APRIL 18, 1988, by T.M. WARREN...

RWK
PTS W/FF
DDO 2/11/162