


T.2S, R.4W, W.M.

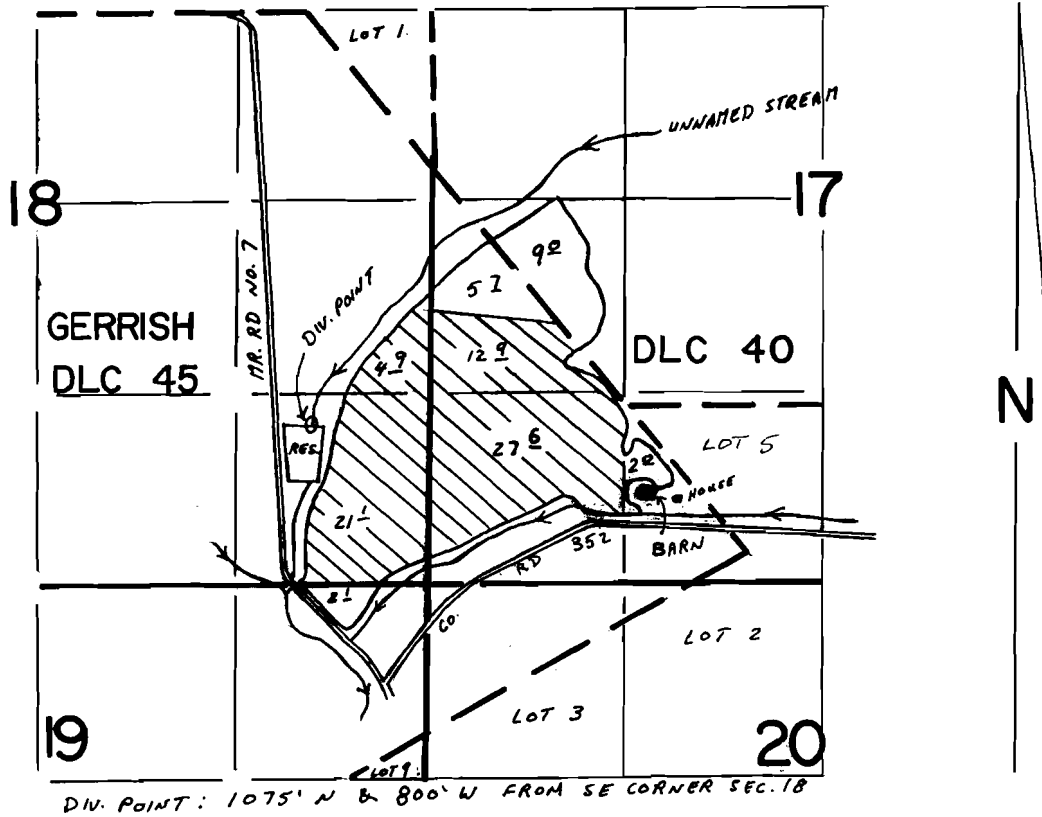

SCALE 1" = 1320'

FINAL PROOF SURVEY

UNDER

R-64158

R-8536

Application No. 64159 Permit No. 47160

IN NAME OF

ROBERT EPLER

Surveyed OCT. 5, 1988, by Z. SALEH