


T.2S, R.4W, W.M.

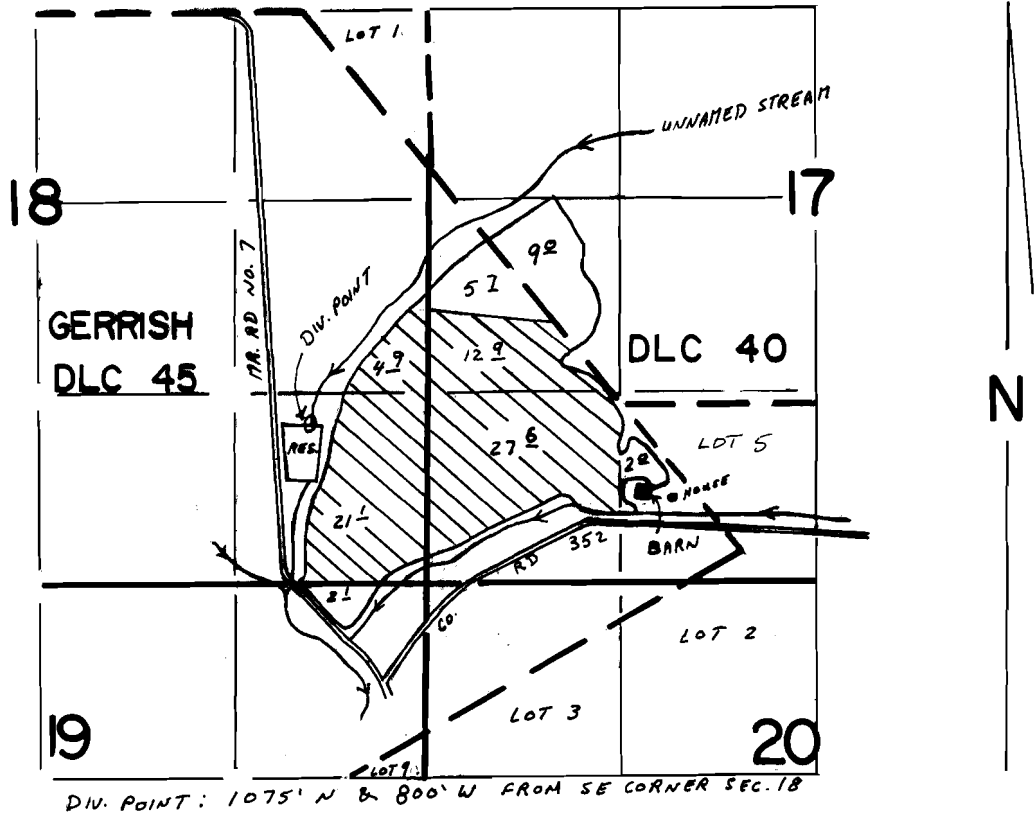

SCALE 1" = 1320'

FINAL PROOF SURVEY

UNDER

R-64158

R-8536

Application No. **64159** Permit No. **47160**

IN NAME OF

ROBERT EPLER

Surveyed **OCT. 5**, 19**88**, by **Z. SALEH**