


# T15S, R31 & 32E, WM

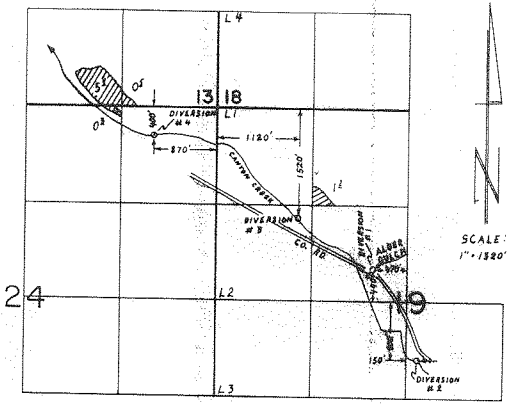

## FINAL PROOF SURVEY UNDER

- ALDER GULCH
- CANYON CREEK

Application No. 54557, Permit No. 47239  
IN NAME OF

PETER R. RICHARD & TIMOTHY R. RAWLINS

Surveyed JUNE 21, 1988, by J.M. WARREN