


Copy
Application No. 64887
Permit No. 48625

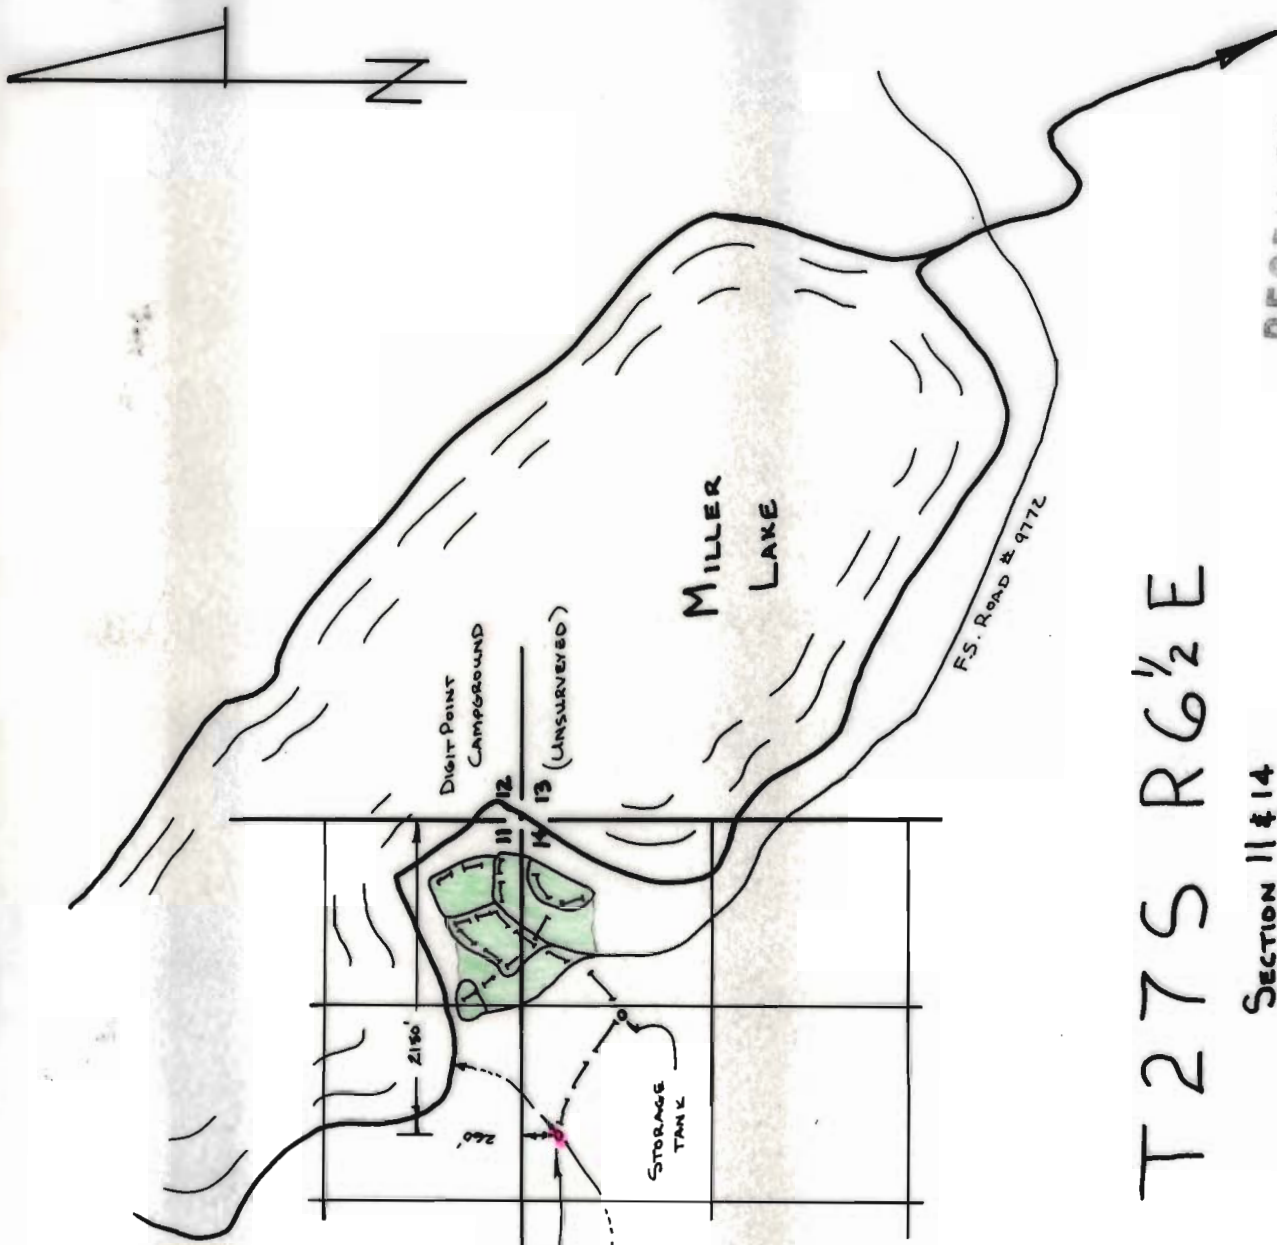

LEGEND
--- WATER PIPE
o SPRING
--- ROAD
o STORAGE TANK

T 27 S R 6 1/2 E

SECTION 11 & 14
UNITE STATES, WINEMA NATIONAL FOREST

DIGIT POINT CAMPGROUND
132.0
SCALE 1" = 1000'

RECEIVED

WATER RESOURCES DIV
SALEM, OREGON