


T. 14S., R. 9W., W.M.

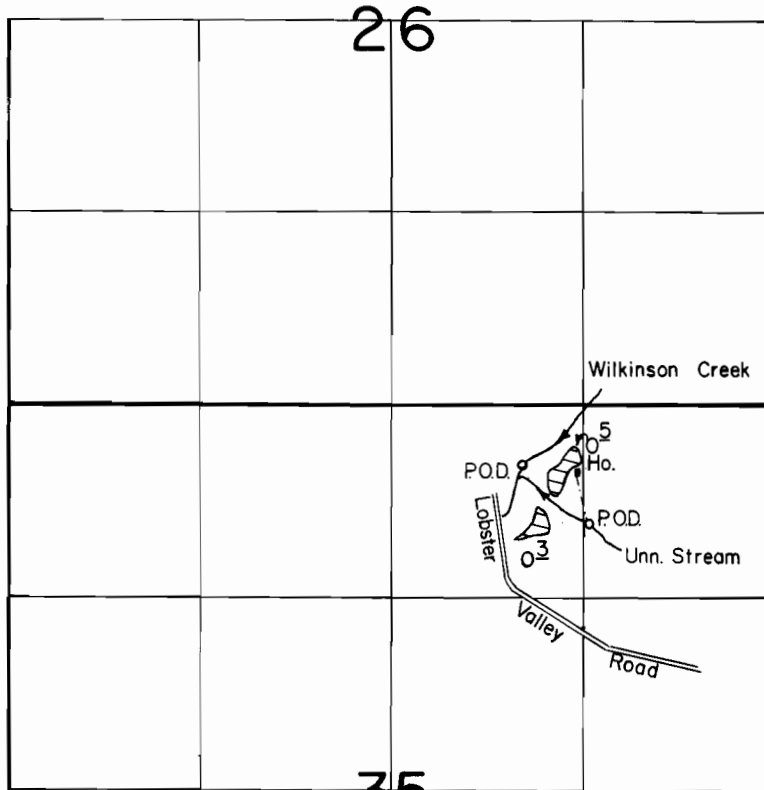

Wilkinson Creek P.O.D. Loc. : 400' S. & 900' E. AND
 Unnamed Stream P.O.D. : 800' S. & 1360' E., both from N. 1/4 Cor. Sec. 35.

Scale : 1" = 1320'

FINAL PROOF SURVEY
UNDER

Application No. 65089. Permit No. 47812.....
IN NAME OF

MARY KELTNER ROUNDS

Surveyed May...19... 1988., by T. WARREN.....