


Tract X


Application No. 05299  
Permit No. 47921

Approx. location of  
SE corner of  
Section 7  
T.23 S., R.6 E., W.M.

RECEIVED  
SEP 19 1983  
RESOURCES

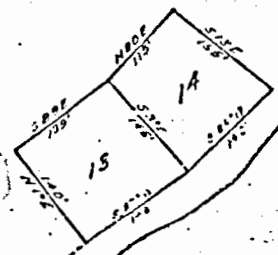

LAKE

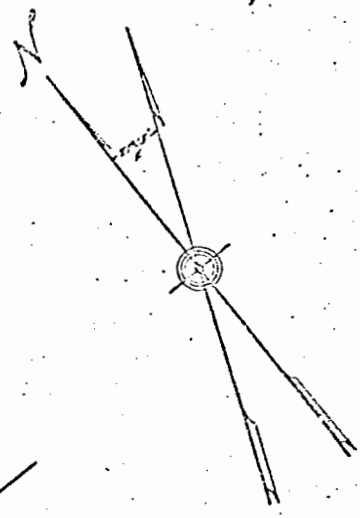

Tax Lot 5100  
(Blohm)

STORAGE  
TANK

Tax Lot 5000  
(MANLOVE)

WATER SUPPLY  
LINE

510 ft.  
(APPROX)

POINT OF  
DIVERSION


Approved

Forest Supervisor

ODELL LAKE RECREATION RESIDENCE SITE  
TRACT X  
DESCHUTES NAT'L. FOREST  
Approx. Sec. 7, T.23S, R.6E, W.M., Unsurveyed

Scale 1 in. = 222 ft.  
Mag. Dec. - 21° 45' E.  
Surveyed Sept 24-25, 1976  
by  
Francis E. Williamson, Jr.  
and by  
R.L. Freeman.

SCALE IN FEET

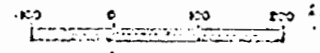

CODE 8

NFRS NO. 208.0

15 G 119  
14 G 118

238