


T. 4 N., R. 8 W., W.M.

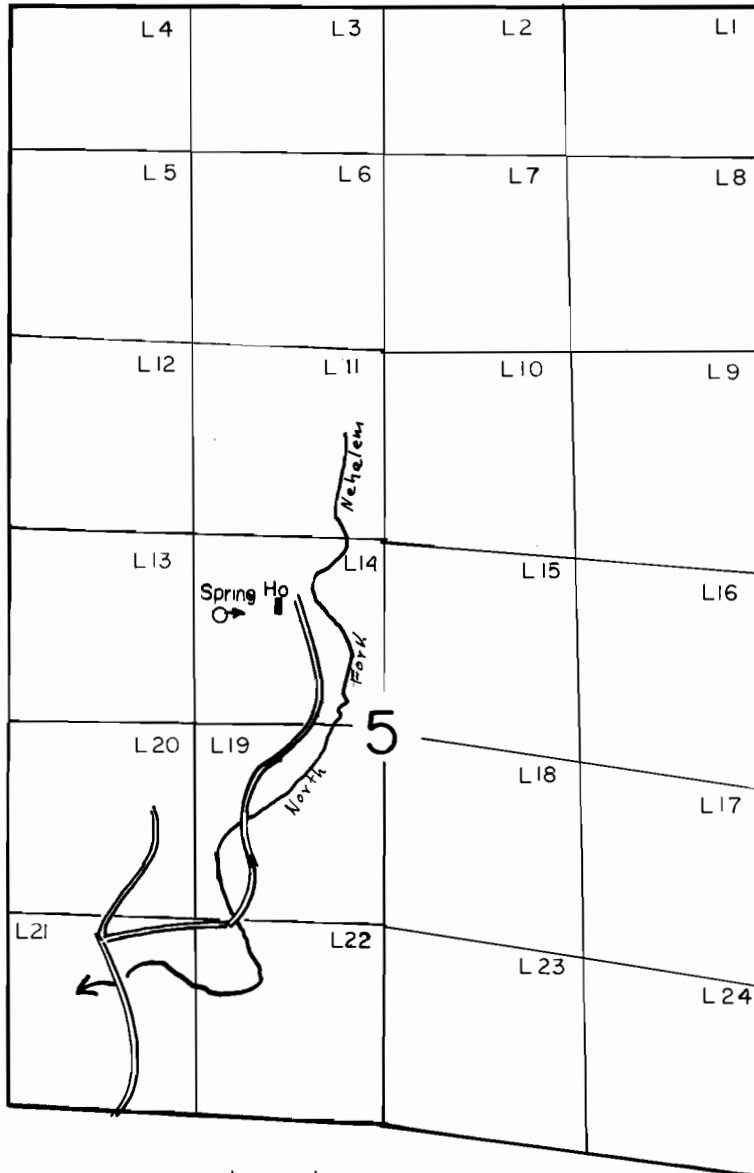

Spring Located 750' N & 150' E From SW Corner Lot 14

SCALE: 1" = 1320'

FINAL PROOF SURVEY UNDER

Application No. 67102... Permit No. 48405...
IN NAME OF

.....
Surveyed JUNE 21... 1989., by J.M. WARREN.....