


0684

T2N, R12E, WM

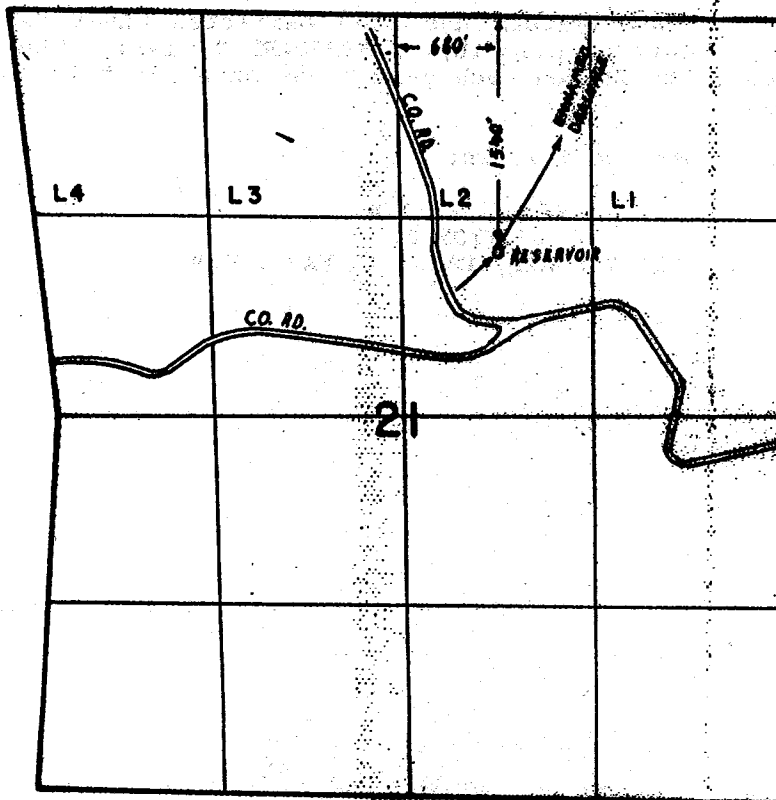

SCALE:
1" = 1320'

FINAL PROOF SURVEY
UNDER

Application No. R-67710 Permit No. R-9399.....
IN NAME OF

.....J. JOHN BURBANK.....

Surveyed APRIL 11, 1988, by T.M. WARREN.....