McKenzie R.
2-2

T17S, R3W, WM

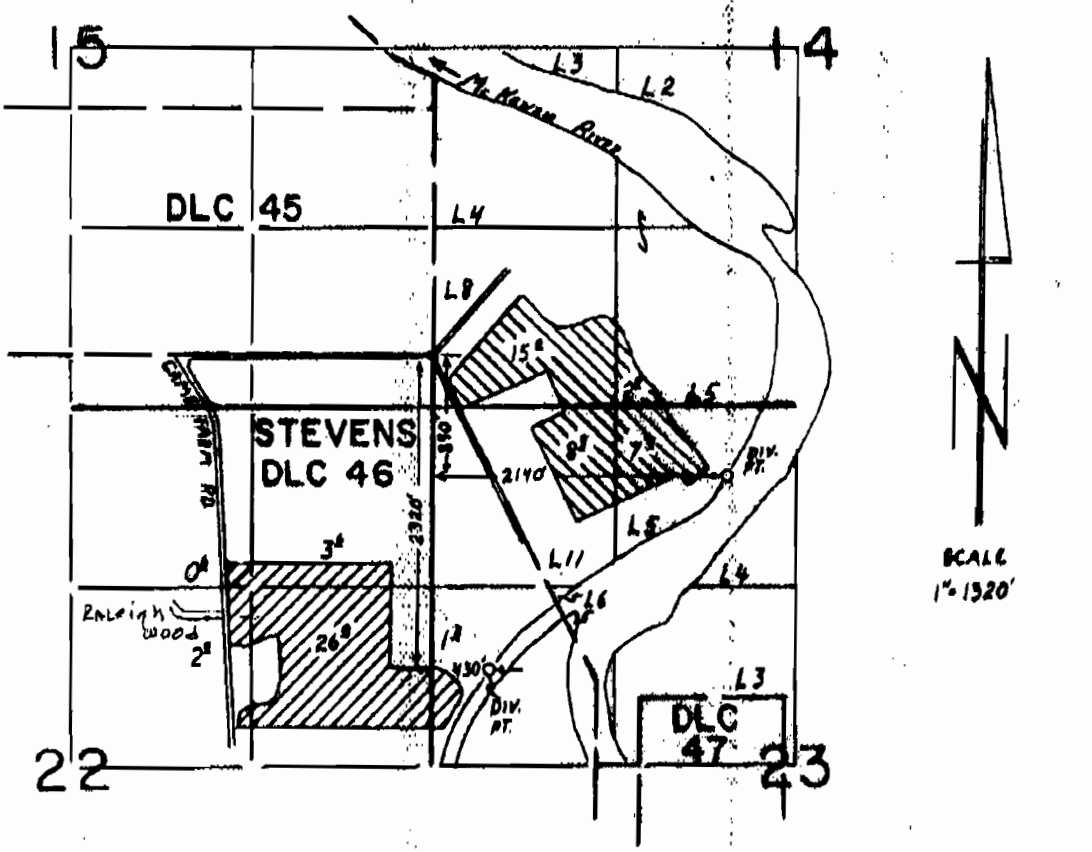

PERMIT 48422

PERMIT 48454

FINAL PROOF SURVEY
UNDER

Application No. 67719 / 67720 Permit No. 48422 / 48454
IN NAME OF

DURWOOD L. BOYLES

Surveyed APRIL 19, 1988, by T.M. WARREN

RWR