


T.14&15S., R4W., W.M.

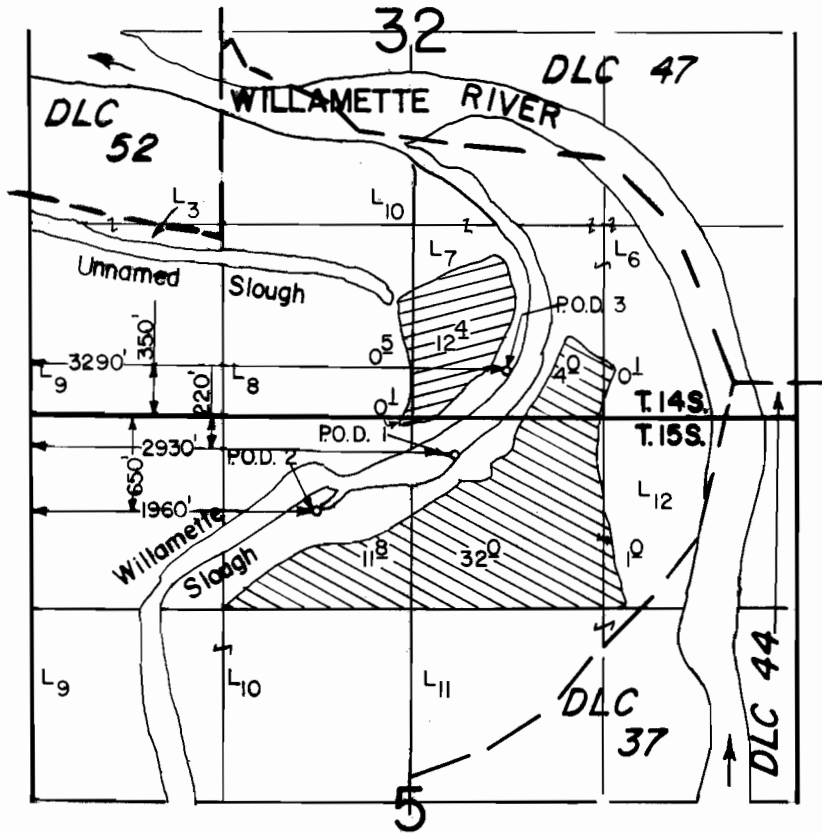

Scale : 1" = 1320'

FINAL PROOF SURVEY
UNDER

Application No. 67950... Permit No. 48115.....

IN NAME OF

DELBERT C. PITCHER

Surveyed Sept. 6... 1988., by T. Warren.....