


T. 18S., R. 46E., W. M.

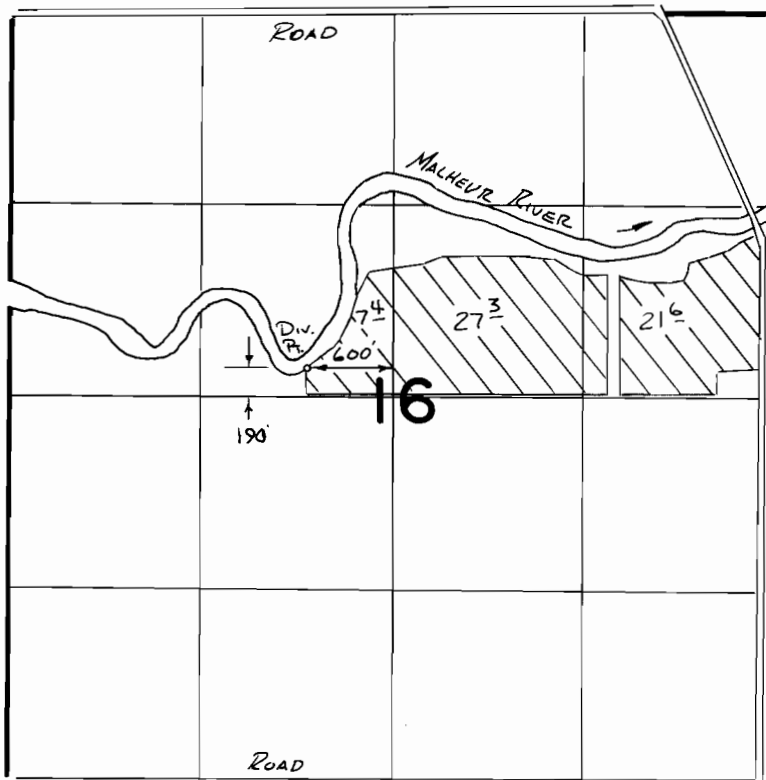

SCALE 1" = 1320'

**FINAL PROOF SURVEY**  
UNDER

Application No. **67962** Permit No. **50045**  
IN NAME OF

**LEROY McBRIDE**

Surveyed **5-23** 19**88**, by **V.L. Church**