


T.8S. R.5 W., W.M.

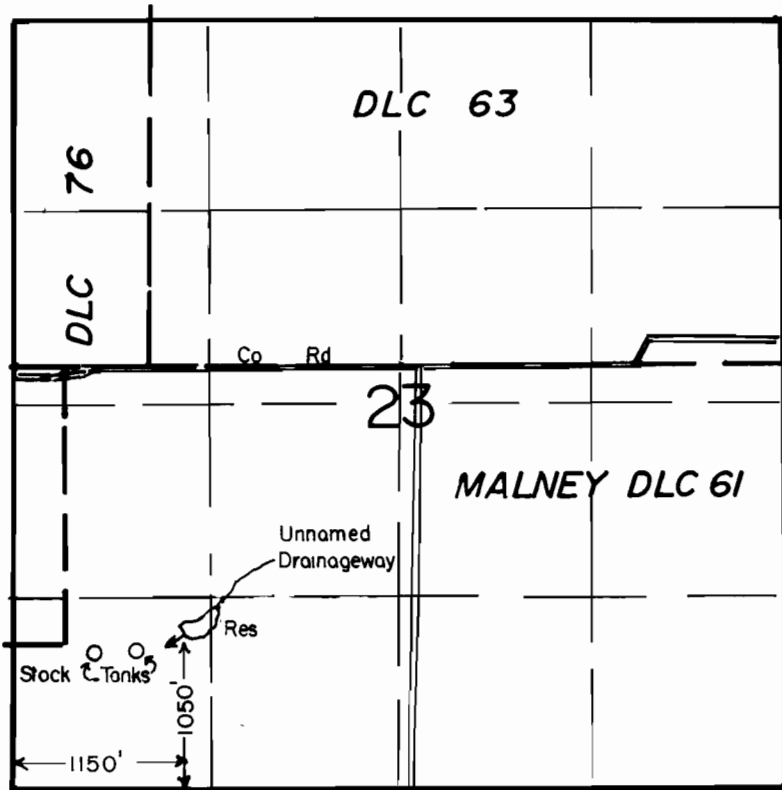

SCALE: 1"=1320'

FINAL PROOF SURVEY
UNDER

R-68062 R-9850

Application No. 68063 Permit No. 48471

IN NAME OF

HELMUT BLUME

Surveyed MAY 11, 1989, by T.M. WARREN