


RECEIVED

APR 18 1984

WATER RESOURCES DEPT.
SALEM, OREGON

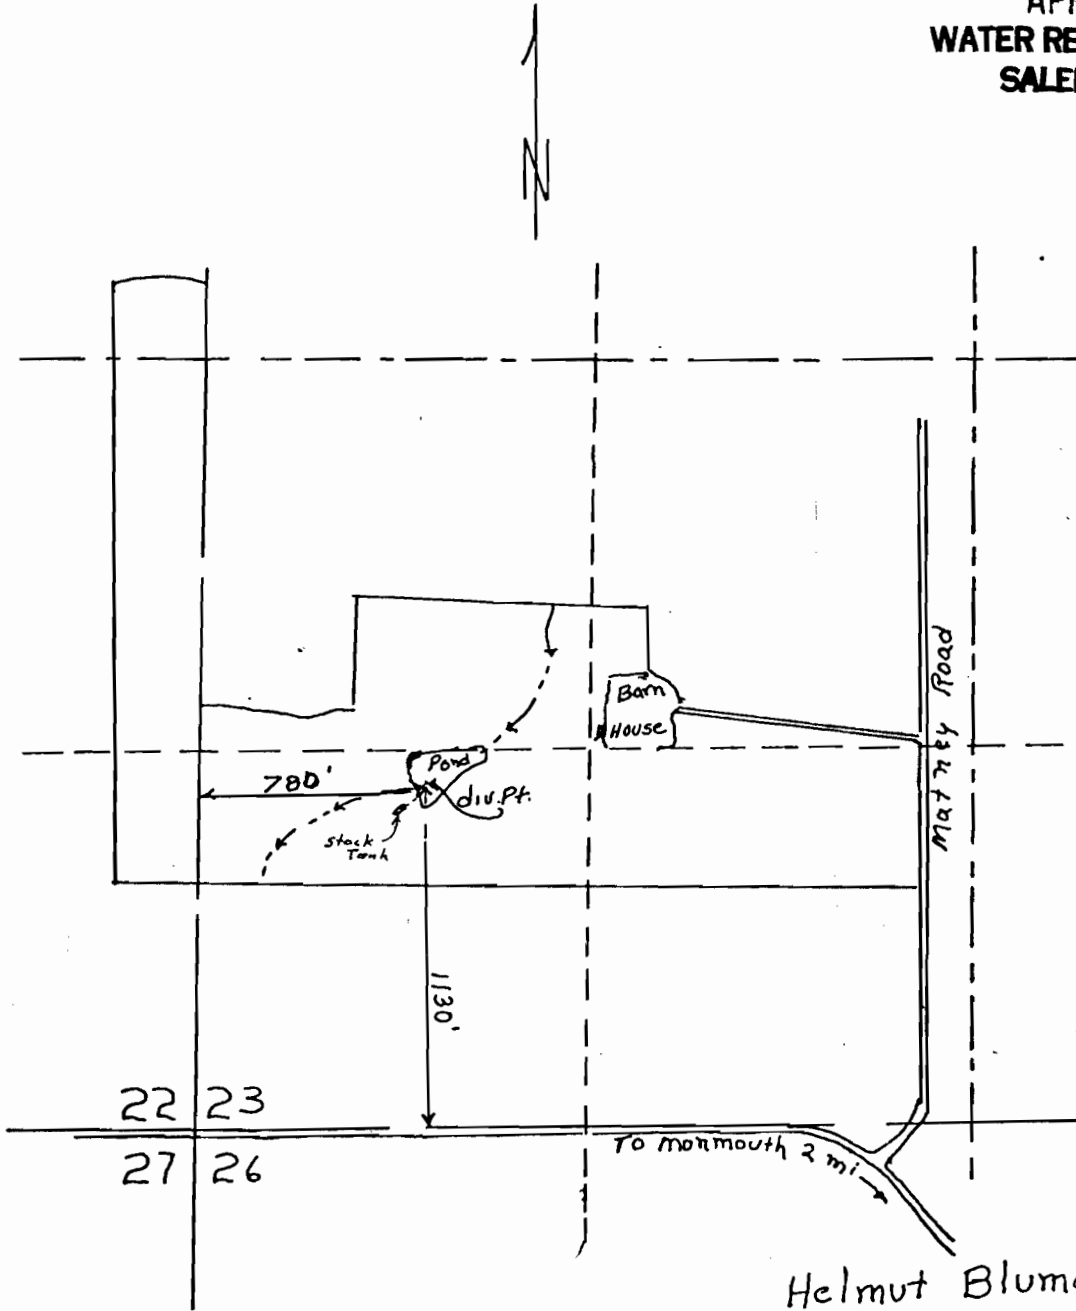

Helmut Blume
T8S R5W
Scale 1" = 660'

Application No.
Permit No.

R-68062 & 68063
R 9850 48471