



T6S, R1W, WM

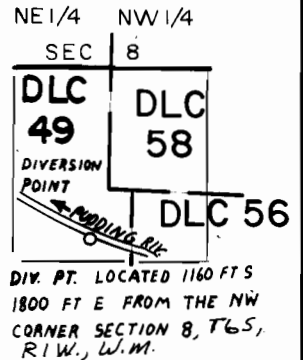

FINAL PROOF SURVEY UNDER

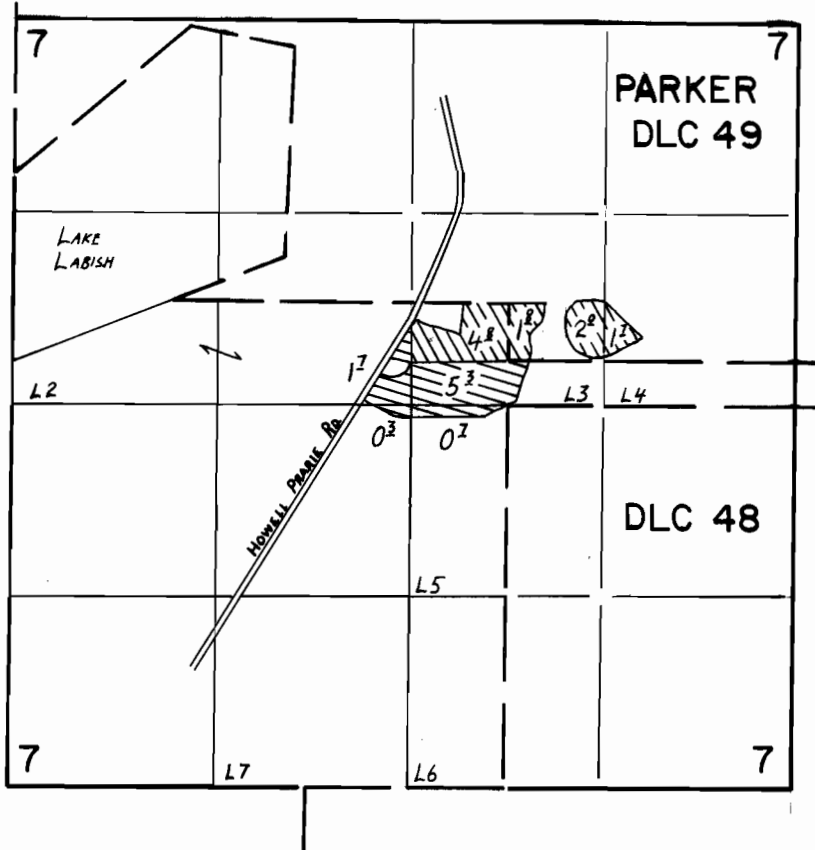

Application No. 68154... Permit No. 48763.....
IN NAME OF

MELVIN KAUFMAN

Surveyed APRIL 29 1988., by T.M. WARREN.