


T. 3 S., R. 3 W., W.M.

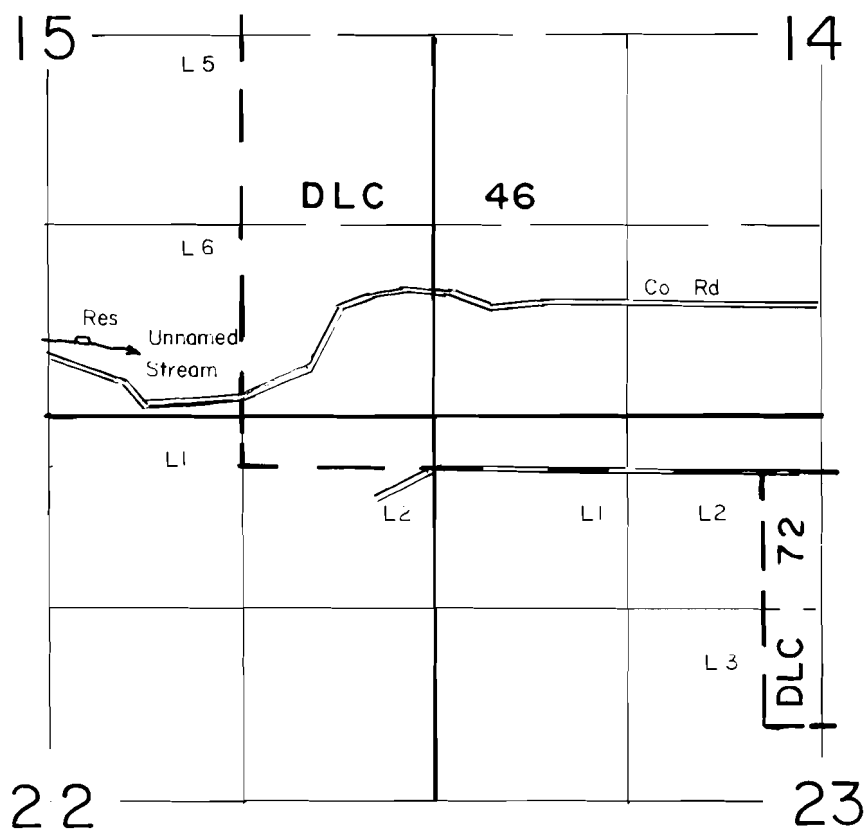

Res Loc 500' N & 300' E From The 1/4 Corner Of Section 15

SCALE: 1" = 1320'

FINAL PROOF SURVEY UNDER

Application No. R-68530 Permit No. R-10607
IN NAME OF

GARY ELVIN TRINKLEIN

Surveyed APRIL 18, 1989, by T.M. WARREN