


T.1S., R.4W., W.M.

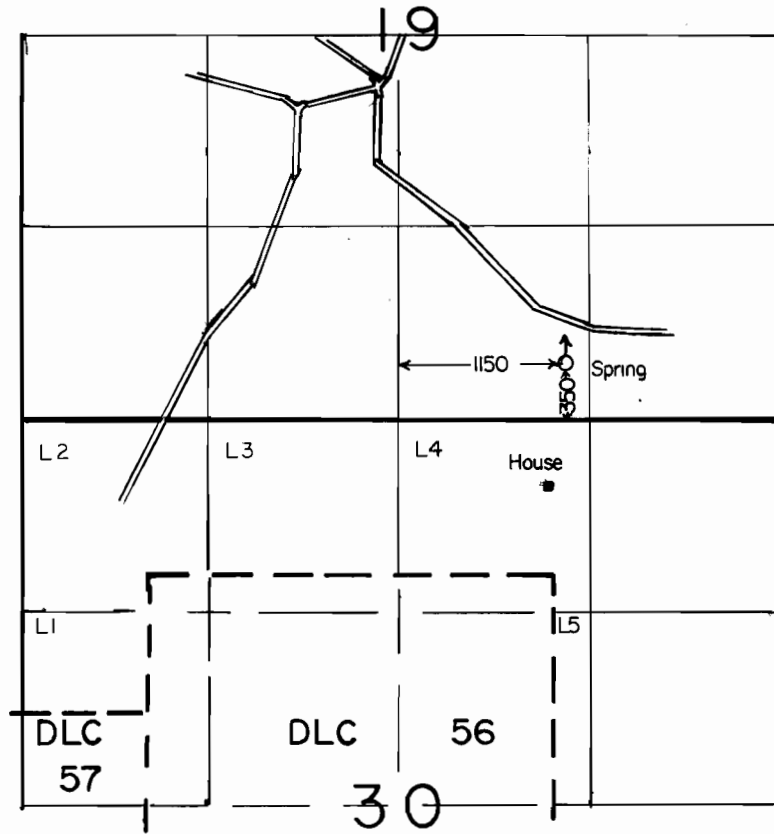

SCALE: 1"=1320'

FINAL PROOF SURVEY
UNDER

Application No. 68.929.... Permit No. 49911.....

IN NAME OF

GEOFFREY R. & MELODIE K. ORIET.....

Surveyed JUNE 7..... 1989., by T.M. WARREN.....