


T2N, R13E, WM

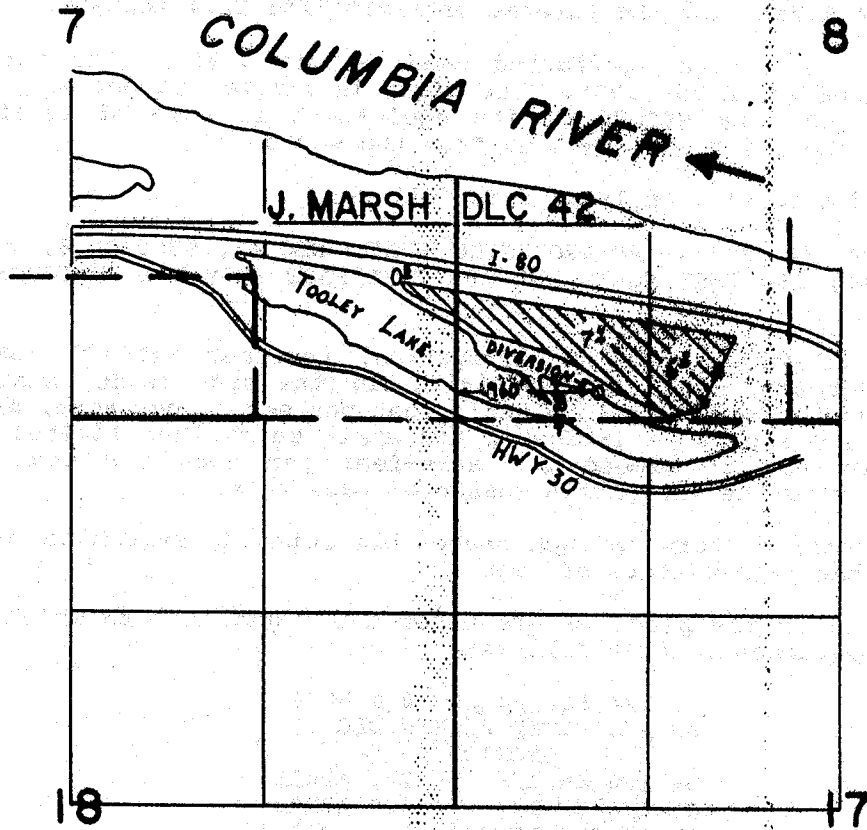

FINAL PROOF SURVEY
UNDER

Application No. 68979.. Permit No. 49914.....
IN NAME OF

.....PHIL D. MOORE.....

Surveyed JUNE...9... 1988, by T. M. WARREN....

RVK