


T. 2&3S. R. 5E. W.M.

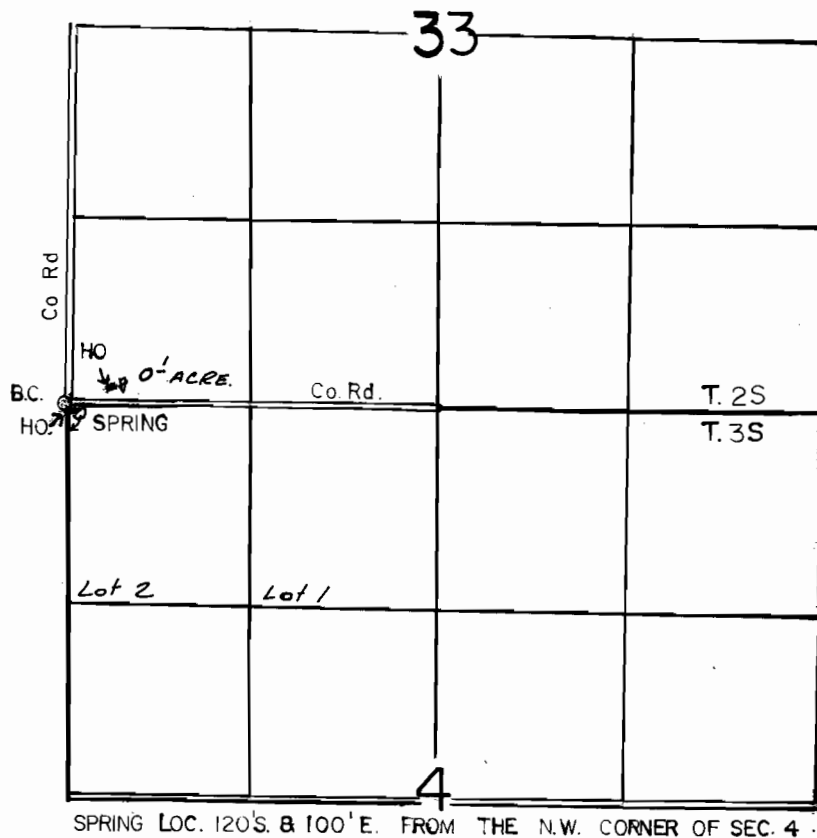

SPRING LOC. 120'S. & 100'E. FROM THE N.W. CORNER OF SEC. 4

SCALE: 1" = 1320'

FINAL PROOF SURVEY

UNDER

Application No. 49212..... Permit No. 36890.....
IN NAME OF

JAMES J. WOLF

Surveyed J. JULY. 15. 1987., by J. M. WARREN.....