


T.34S.R.3W.W.M.

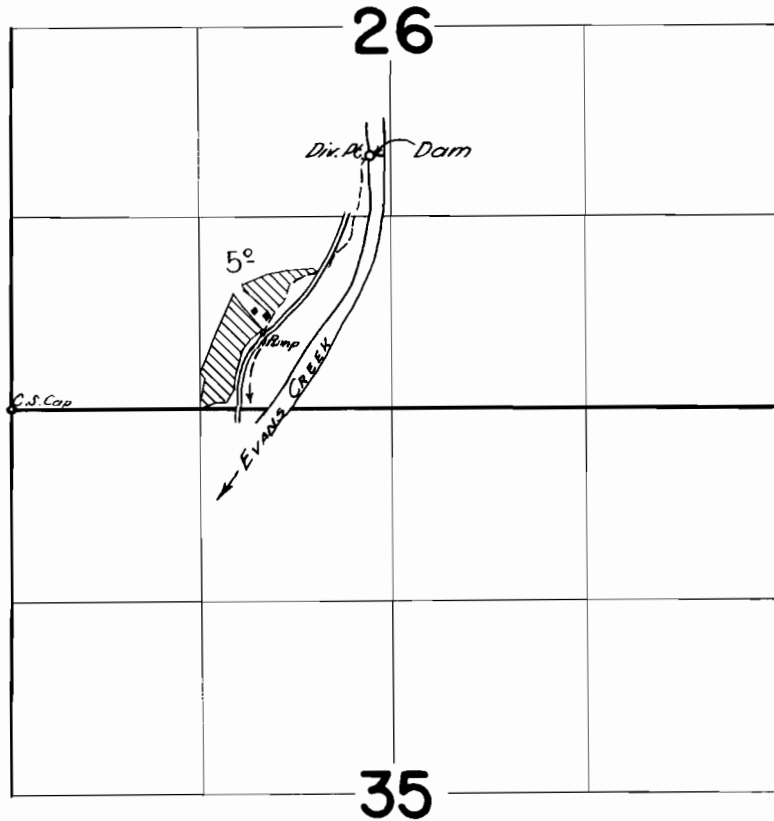

FINAL PROOF SURVEY
UNDER

Application No. 34595... Permit No. 27166...
IN NAME OF

ALFRED J. BOULTER

Surveyed May 15, 1963, by *R. Jackson*