


# T.13S. R. 29E.W.M.

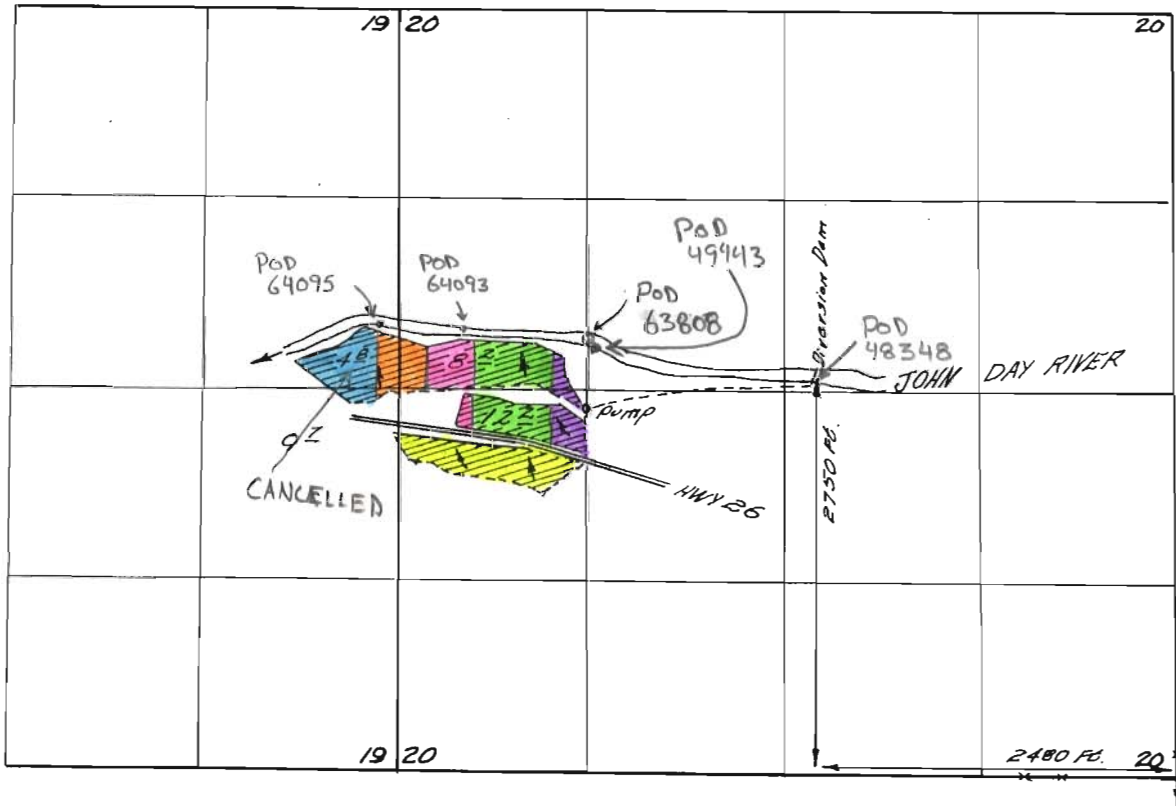

COPY

## FINAL PROOF SURVEY UNDER

Application No. 38853 Permit No. 28944  
IN NAME OF

WALLACE F. CAMPBELL

Surveyed July 18 1968, by W. d. Ruppert

# TRANSFER TREE

