


T.13S. R. 29E.W.M.

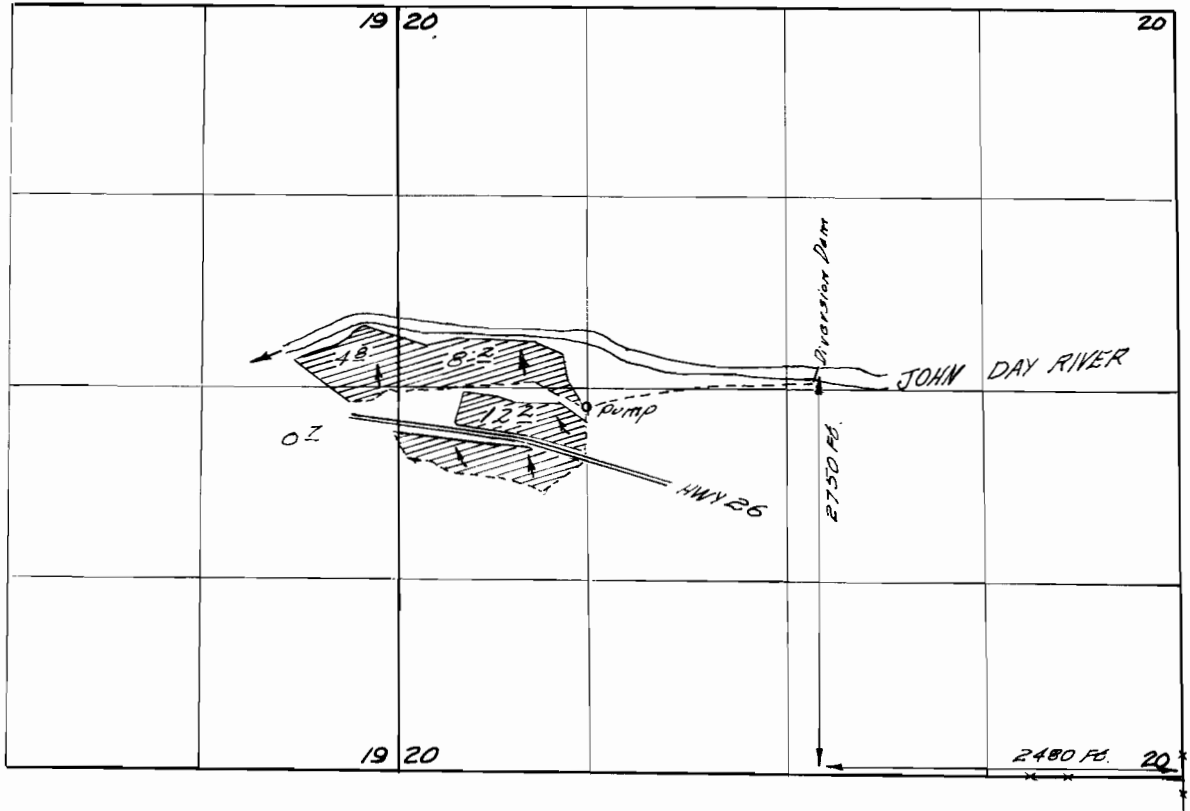

FINAL PROOF SURVEY UNDER

Application No. 38853. Permit No. 28944
IN NAME OF

WALLACE F. CAMPBELL

Surveyed July 18 1968, by W. L. Ruppert