


T.19S.R.12W.W.M.

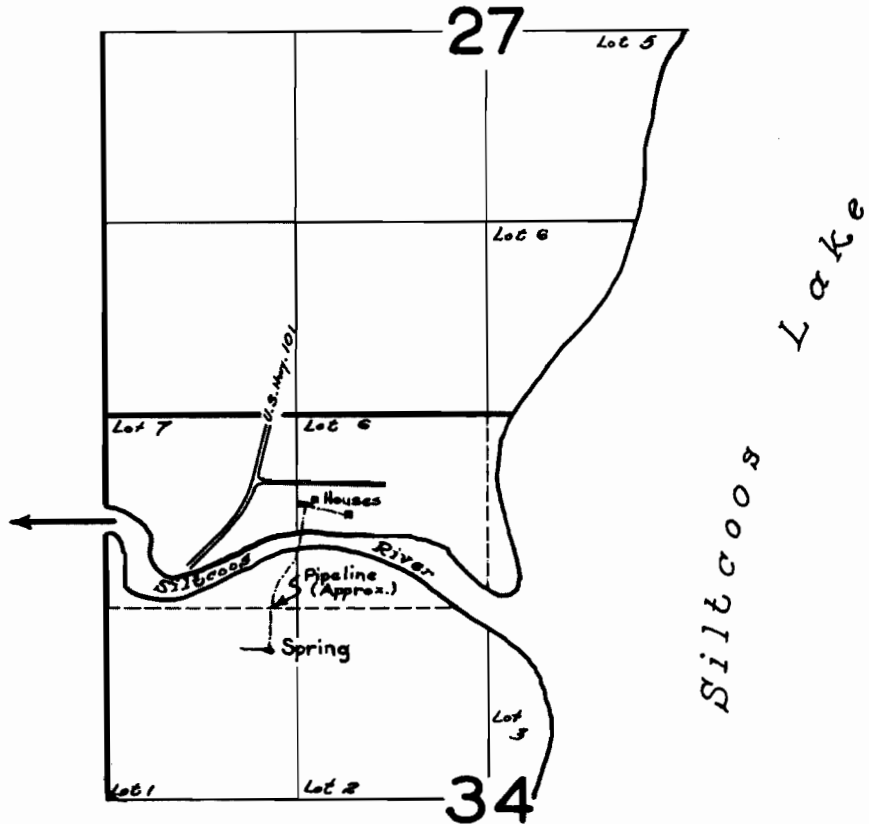

FINAL PROOF SURVEY
UNDER

Application No. 30034... Permit No. 23644...
IN NAME OF

Harvey Paul Hanson & Ray Risenhuber

Surveyed May 10, 1962, by *Alf Peterson*