


T. 2N., R. 16 & 17E., W.M.

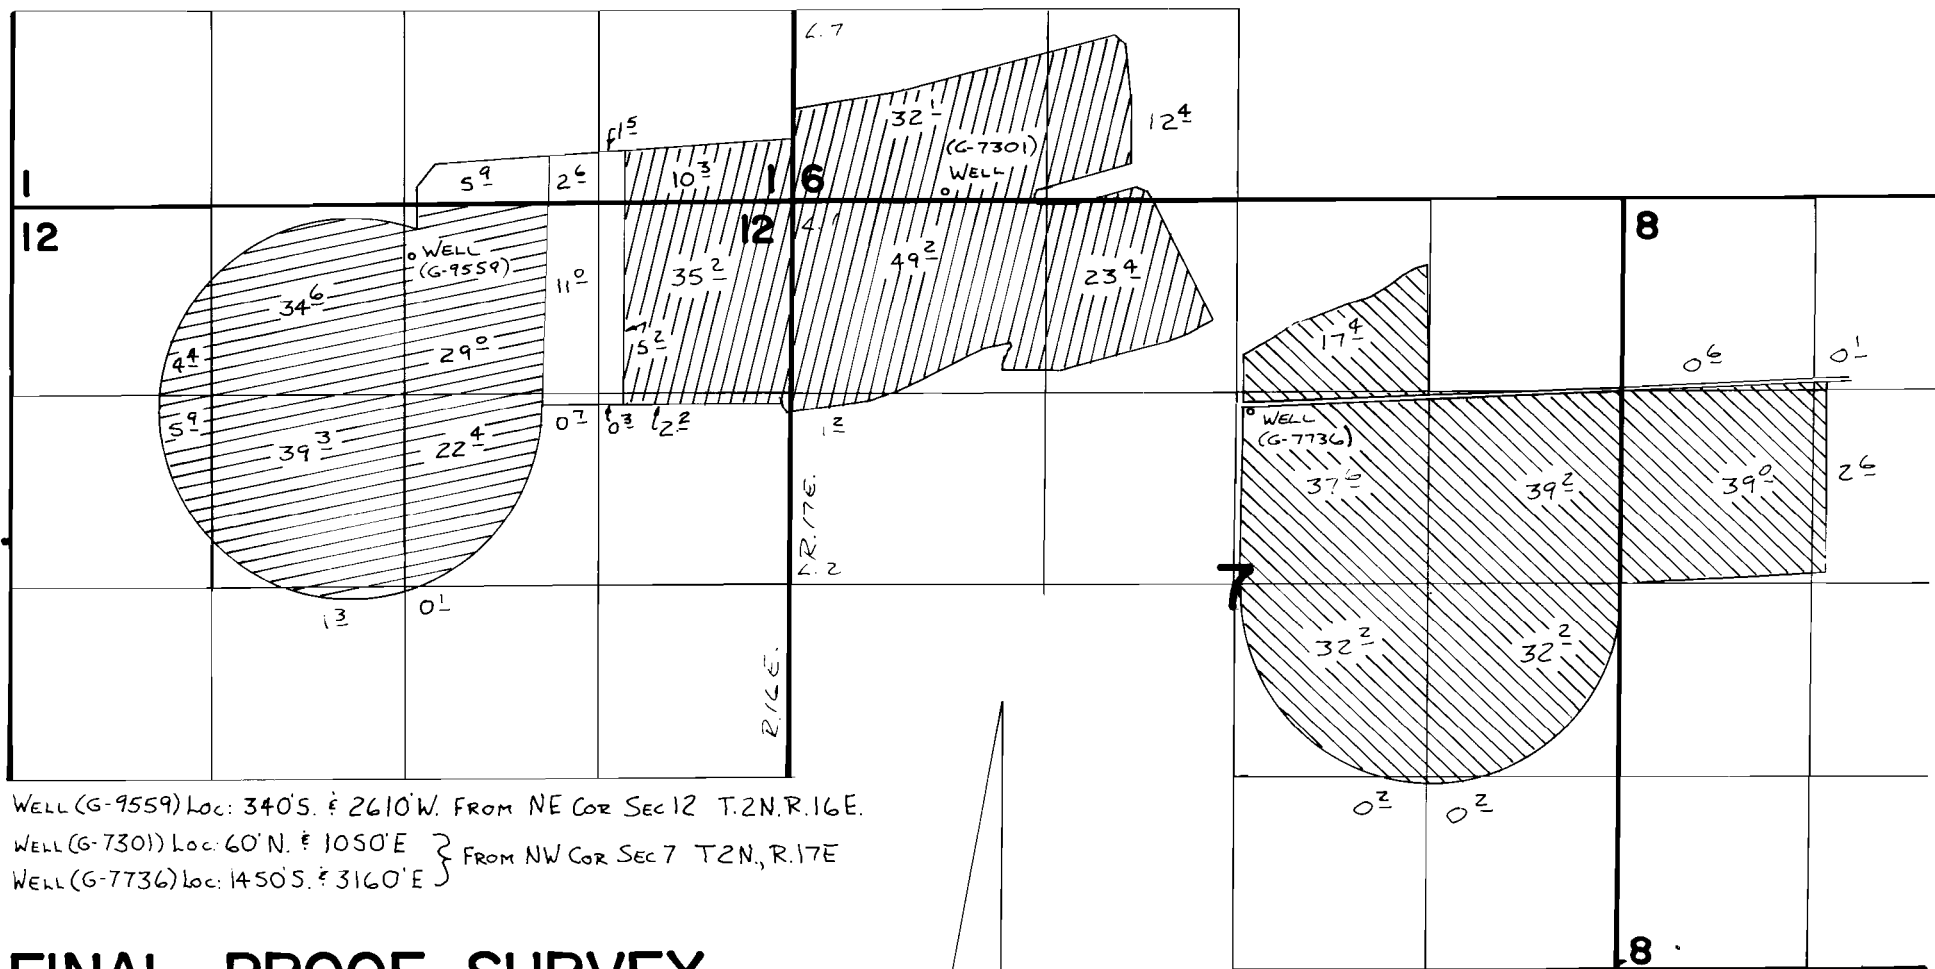

WELL (G-9559) Loc: 340' S. & 2610' W. FROM NE COR SEC 12 T. 2N. R. 16E.

WELL (G-7301) Loc: 60' N. & 1050' E. FROM NW COR SEC 7 T. 2N., R. 17E

WELL (G-7736) Loc: 1450' S. & 3160' E. FROM NW COR SEC 7 T. 2N., R. 17E

# FINAL PROOF SURVEY UNDER

APPL. G-8393  
G-7891  
G-10048

PER. G-7736  
G-7301  
G-9559

IN NAME OF

WILLIM F. & BARBARA B. MARTIN

SURVEYED 5-6 1985, by V.L. Church

SCALE 1" = 1320'

