


G-8987  
62687

T.38 S., R.20 E., W.M.

64110

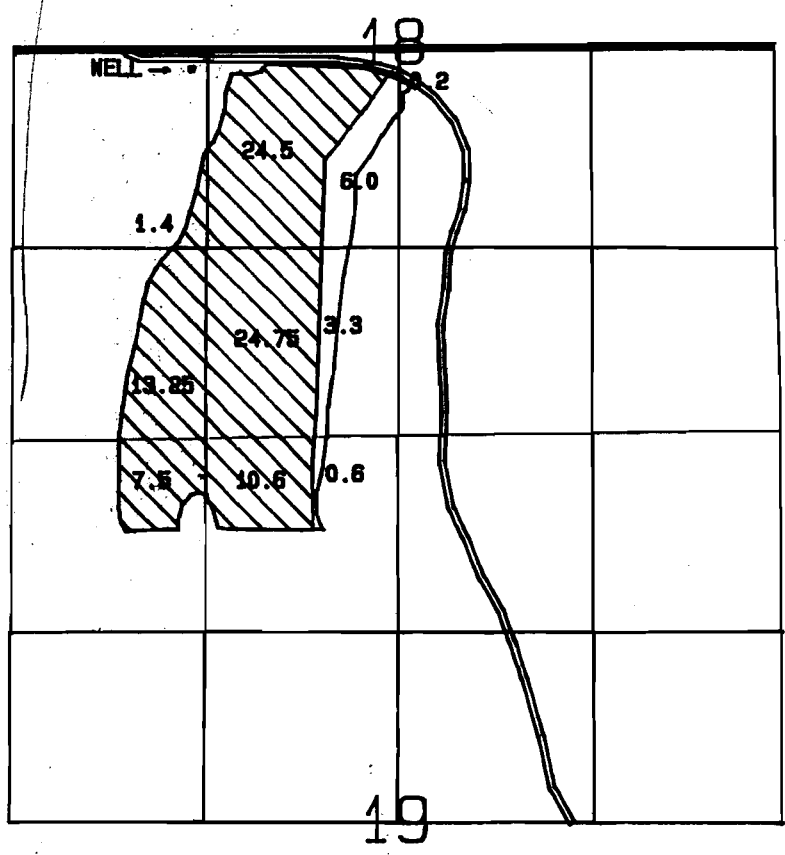

WELL LOCATED 1200 FT. E. AND 100 FT. S. FROM N 1/4 SEC 18

SCALE: 1 IN. = 1320

FINAL PROOF SURVEY

UNDER

Application No. 6-9735 Permit No.6-8987

IN NAME OF

70 RANCH INC.

Surveyed Oct.19, 1987 By B.S.JAMES

Photo: 379 74C DLN