


T. 19S., R. 44E., W.M.

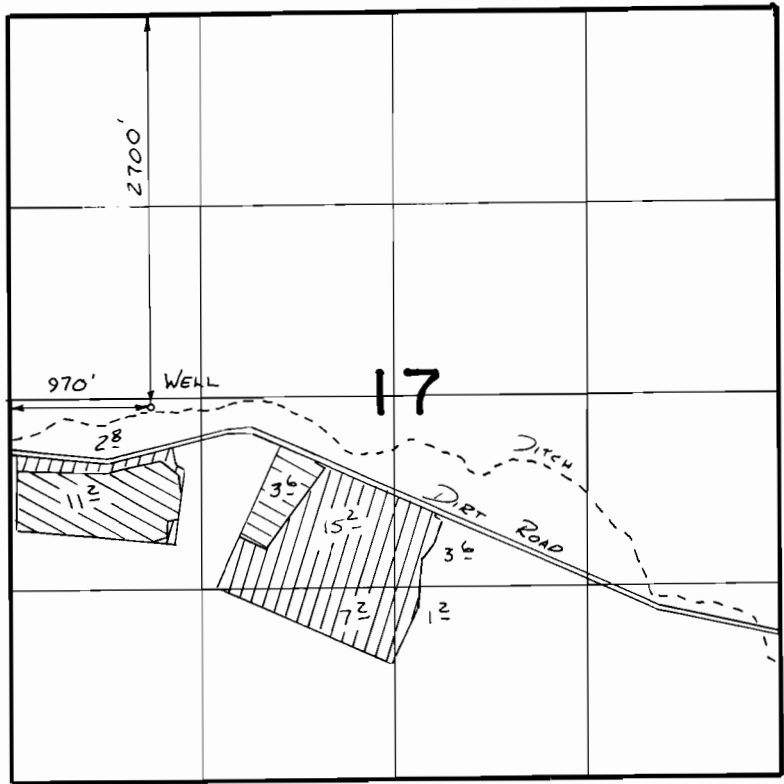

SCALE 1" = 1320'



Prim.



Suppl.

FINAL PROOF SURVEY
UNDER

Application No. **G-10106** Permit No. **G-9198**
IN NAME OF

BISHOP BROTHERS

Surveyed **0-11** 19**88**, by **V.L. Church**