
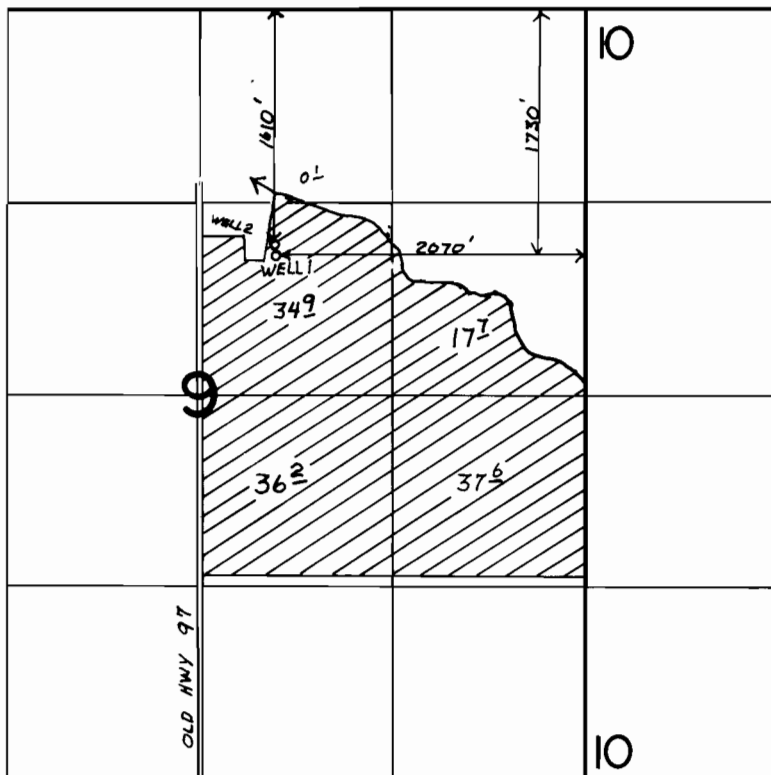


T.1N., R.17E., W.M.

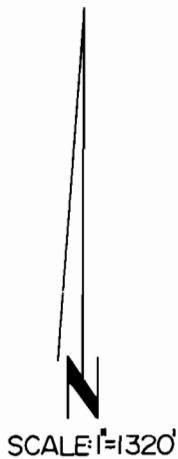

FINAL PROOF SURVEY UNDER

Application No. G-10187 Permit No. G-9998

IN NAME OF

VIRGINIA McINTYRE

Surveyed *May 20* 19*85*, by *V.L. CHURCH*