


T. 8 S. R. 40 E. W. M.

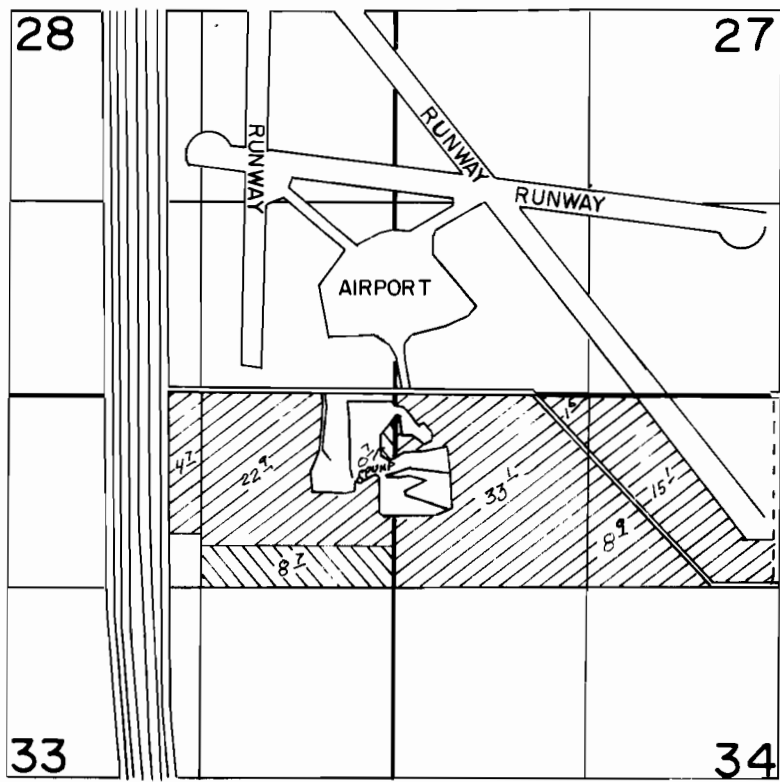

SCALE: 1" = 100'



PUMP LOCATED 600' S. AND 250' W. FROM THE N.E. SEC. COR. SEC. 33

PRIMARY

SUPPLEMENTAL

FINAL PROOF SURVEY UNDER

Application No. G-10456 Permit No. G-9742
IN NAME OF

ELVIN E. CARTER

Surveyed 5-22 1984, by J.L. CHURCH