90684

T. 25S., R. 34E., W.M.

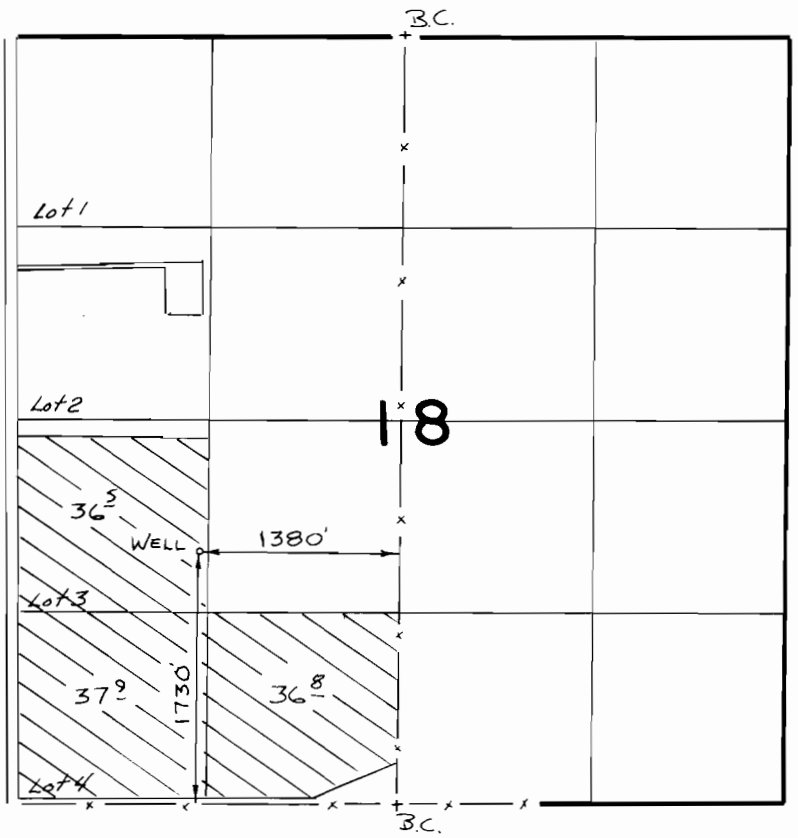

SCALE 1" = 1320'

FINAL PROOF SURVEY

UNDER

Application No. G:10514 Permit No. G:9673

IN NAME OF

BILL & MELINDA SCHAFFER

Surveyed 5-9 1988, by V.L. Church

11025-179-1936 12-23-88 V.L.C