


T.1N.&S., R.4E. W.M.

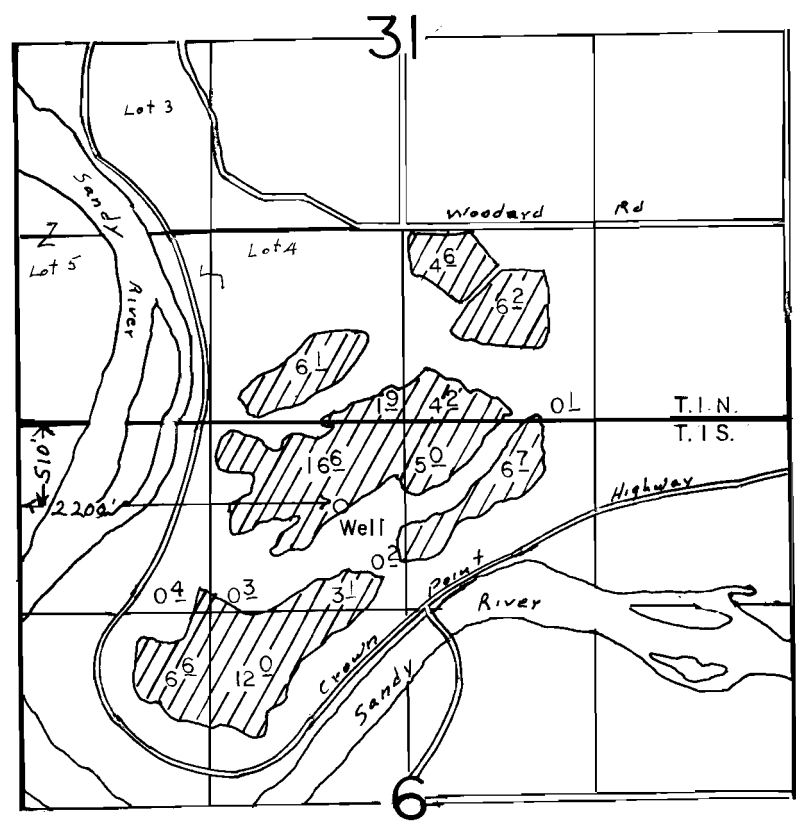

SCALE: 1" = 1320'

FINAL PROOF SURVEY UNDER

Application No. G-10626 Permit No. G-2735...
IN NAME OF

...HOWARD A. & RUTH L. WINTERS

Surveyed MAY 11, 1987, by T.M. WARREN...