


T. 35 S., R. 5 W., W. M.

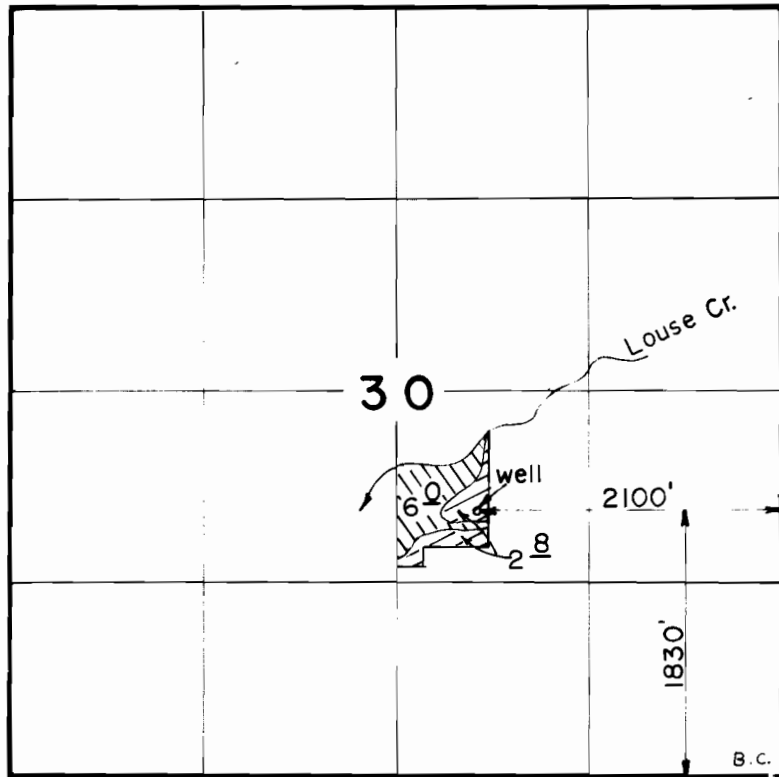

Scale: 1" = 1320'

FINAL PROOF SURVEY
UNDER

Application No. G-10718 Permit No. G-9889...
IN NAME OF

LAWRENCE J. & EMMA J. LENGWIN

Surveyed JUL. 30. 19.87, by B. S. JAMES...