


T. 25S., R. 34E., W.M.

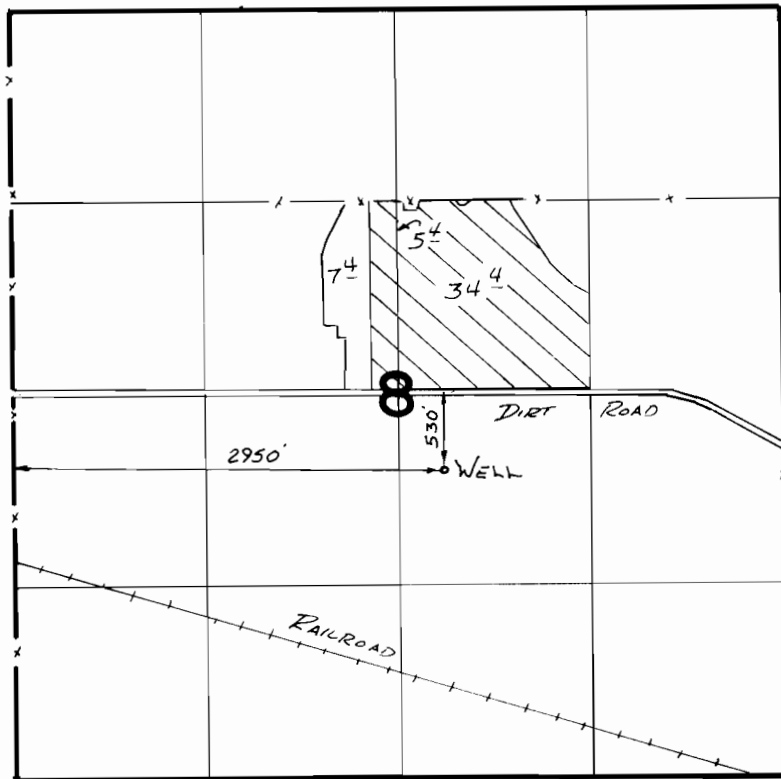

Scale 1" = 1320'

FINAL PROOF SURVEY
UNDER

Application No. **G:10823** Permit No. **G:9992**
IN NAME OF

CLAYTON KING

Surveyed **5-7** 19**88**, by **V.L. Church**