


G10425
64129
64130

T. 2 S. R. 27 E. W.M.

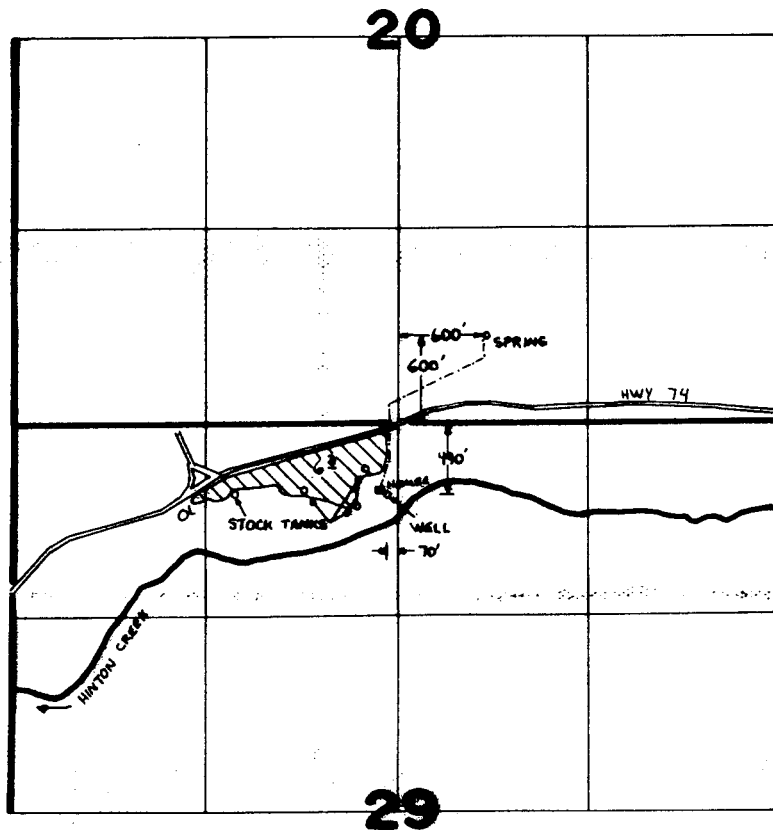

Scale 1" = 1320'



FINAL PROOF SURVEY
UNDER

G10865 G10425
Application No. 6.4.627. Permit No. 48865.....
IN NAME OF

.....**RONALD D. HAMRICK**.....

Surveyed March 11, 1987, by V. Church.....